## SURVEYOR'S NOTES:

- I. BEARINGS ARE BASED ON THE WEST LINE OF SECTION 23, TOWNSHIP 21 SOUTH, RANGE 29 EAST AS BEING NORTH 00°03'34" EAST, AN ASSUMED BEARING.
- 2. FIXED IMPROVEMENTS AND UNDERGROUND ENCROACHMENTS HAVE NOT BEEN LOCATED UNLESS OTHERWISE SHOWN.
- 3. ALL STREETS FOR STREET RIGHT-OF-WAY SHOWN ARE PHYSICALLY OPEN UNLESS OTHERWISE NOTED.
- 4. ALL STATIONING REFERS TO CENTERLINE CONSTRUCTION BASELINE SURVEY.
- 5. PROPERTY BOUNDARIES DETERMINED FROM RECORD FILE
- 6. FOR CENTERLINE REFERENCE DETAILS SEE SHEET 8 OF 8 OF THE CONTROL SURVEY FOR WYMORE ROAD PREPARED BY DONALD A. HORNE, INC.
- 7. THIS RIGHT-OF-WAY MAP IS BASED ON A CONTROL SURVEY PERFORMED BY DONALD A. HORNE, INC. DATED 11/4/1994.

### 8. THIS IS NOT A SURVEY.

### LEGEND:

AC	69.	ACRES	L.A.	- LIMITED ACCESS	
ADD	(69)	ADDITION		- NUMBER	
AH	(68):	AHEAD	NO	- NUMBER	
AKA	488	ALSO KNOWN AS	ORB	- OFFICAL RECORDS BOOK	
0	-	AT	OE	- OVERHEAD ELECTRIC	
BK	6991	BACK	PG	- PAGE	
B		BASELINE	PAVT	- PAVEMENT	
BLK .		BLOCK	PCE	- PERMANENT CONSTRUCTION EASEMENT	
(C)		CALCULATED	PDE	- PERMANENT DRAINAGE EASEMENT	
Ç		CENTERLINE	(P)	PLAT	
		CENTRAL ANGLE	PB	- PLAT BOOK	
CCR		CERTIFIED CORNER RECORD	PG	- PAGE	
C		CHORD	POB		
СВ		CHORD BEARING	POC	- POINT OF BEGINNING	
CONC		CONCRETE		- POINT OF COMMENCEMENT	
CM		CONCRETE MONUMENT	PC	- POINT OF CURVATURE	
CONST		CONSTRUCTION	PL	- POINT OF INTERSECTION	
COR		CORNER	PT	- POINT OF TANGENCY	
CORP		CORPORATION	PP	- POWER POLE	
CT		COURT	PRC	- POINT OF REVERSE CURVATURE	
(0)		DEED		- PROPERTY LINE	
DB		DEED BOOK	R	<ul> <li>RADIUS</li> </ul>	al contraction of the second se
DEPT			RR	* RAILROAD	
DIA		DEPARTMENT	R3IE	* RANGE 31 EAST	
ESMT		DIAMETER	Rac	- REBAR AND CAP	
EXIST		EASEMENT	RT	- RIGHT	
		EXISTING	R/W	RIGHT-OF-WAY	
FLA		FLORIDA	RLS .	- REGISTERED LAND SURVEYOR	
FDOT	编	FLORIDA DEPARTMENT OF	RD	• ROAD	
		TRANSPORTATION	SECT	- SECTION	
FPC		FLORIDA POWER CORPORATION	SRD	STATE ROAD DEPARTMENT	
FP & L		FLORIDA POWER AND LIGHT	STA	* STATION	
FND		FOUND	SF	- SQUARE FEET	
ID		IDENTIFICATION	T	- TANGENT	
LT		LEFT	TCE	<ul> <li>TEMPORARY CONSTRUCTION EASEMENT</li> </ul>	
L.		LENGTH	TWP	- TOWNSHIP	
(M)		MEASURED	T21S	- TOWNSHIP 21 SOUTH	
NAD	<b>501</b>	NAIL AND DISK	TYP	- TYPICAL	

SUDIE

# SEMINOLE COUNTY, FLORIDA

# Pase Contact **RIGHT-OF-WAY MAP** VYMORE ROADEEII FROM COUNTY LINE TO STATE ROAD 436

	INDEX OF SHEETS
SHEET	DESCRIPTION
1	COVER SHEET
2-3	KEY SHEETS
4 - 16	DETAIL SHEETS
17	TABLE OF OWNERSHIPS



Consulting Engineers, Planners & Surveyors 800 South Orlando Avenue, Maitland, Florida 32751 Telephone: (407) 647-6623

# mplete

MAP BOOK

# PAGE

### CERTIFICATE OF BOARD OF COUNTY COMMISSIONERS

I hereby certify that this Right-of-Way Map was approved by the Seminole County Board of County Commissioners on and represents the existing and proposed right-ofway of Wymore Road to the extent shown hereon. The right-of-way identified in the Resolution of Necessity adopted by the Seminole County Board of County Commissioners on\_ \_\_\_, and recorded in the Official Records

\_\_\_, Page \_\_ of the Public Records of Seminole County, Florida

Chairman of the Board

ATTEST:

Clerk of the Board


## CERTIFICATE OF CLERK

I HEREBY CERTIFY that I received this Rightof-Way Map in accordance with the provisions of Section 177.131, Florida Statutes, on this day of

Clerk of the Circuit Court In and For Seminole County, Florida


All survey data shown on this map, consisting of Sheets I through 17, was taken from a control survey prepared by Donald A. Horne and completed on June 16, 1995. Certified copies of this survey are recorded in the office of the Clerk of the Court, Seminole County, Florida




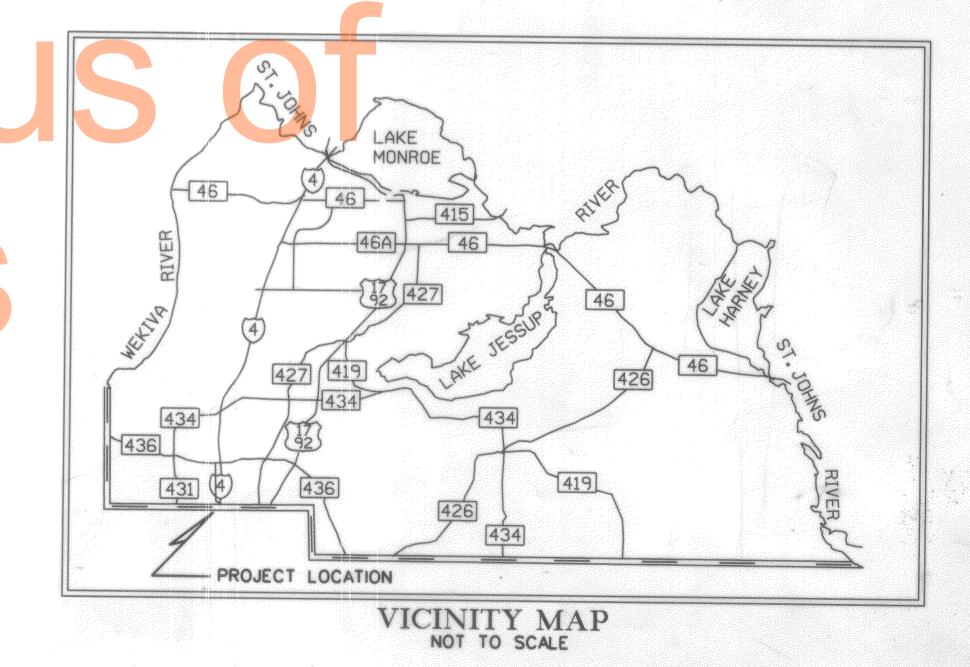


1397-1-02


Sheet 1 of 17 Sheets

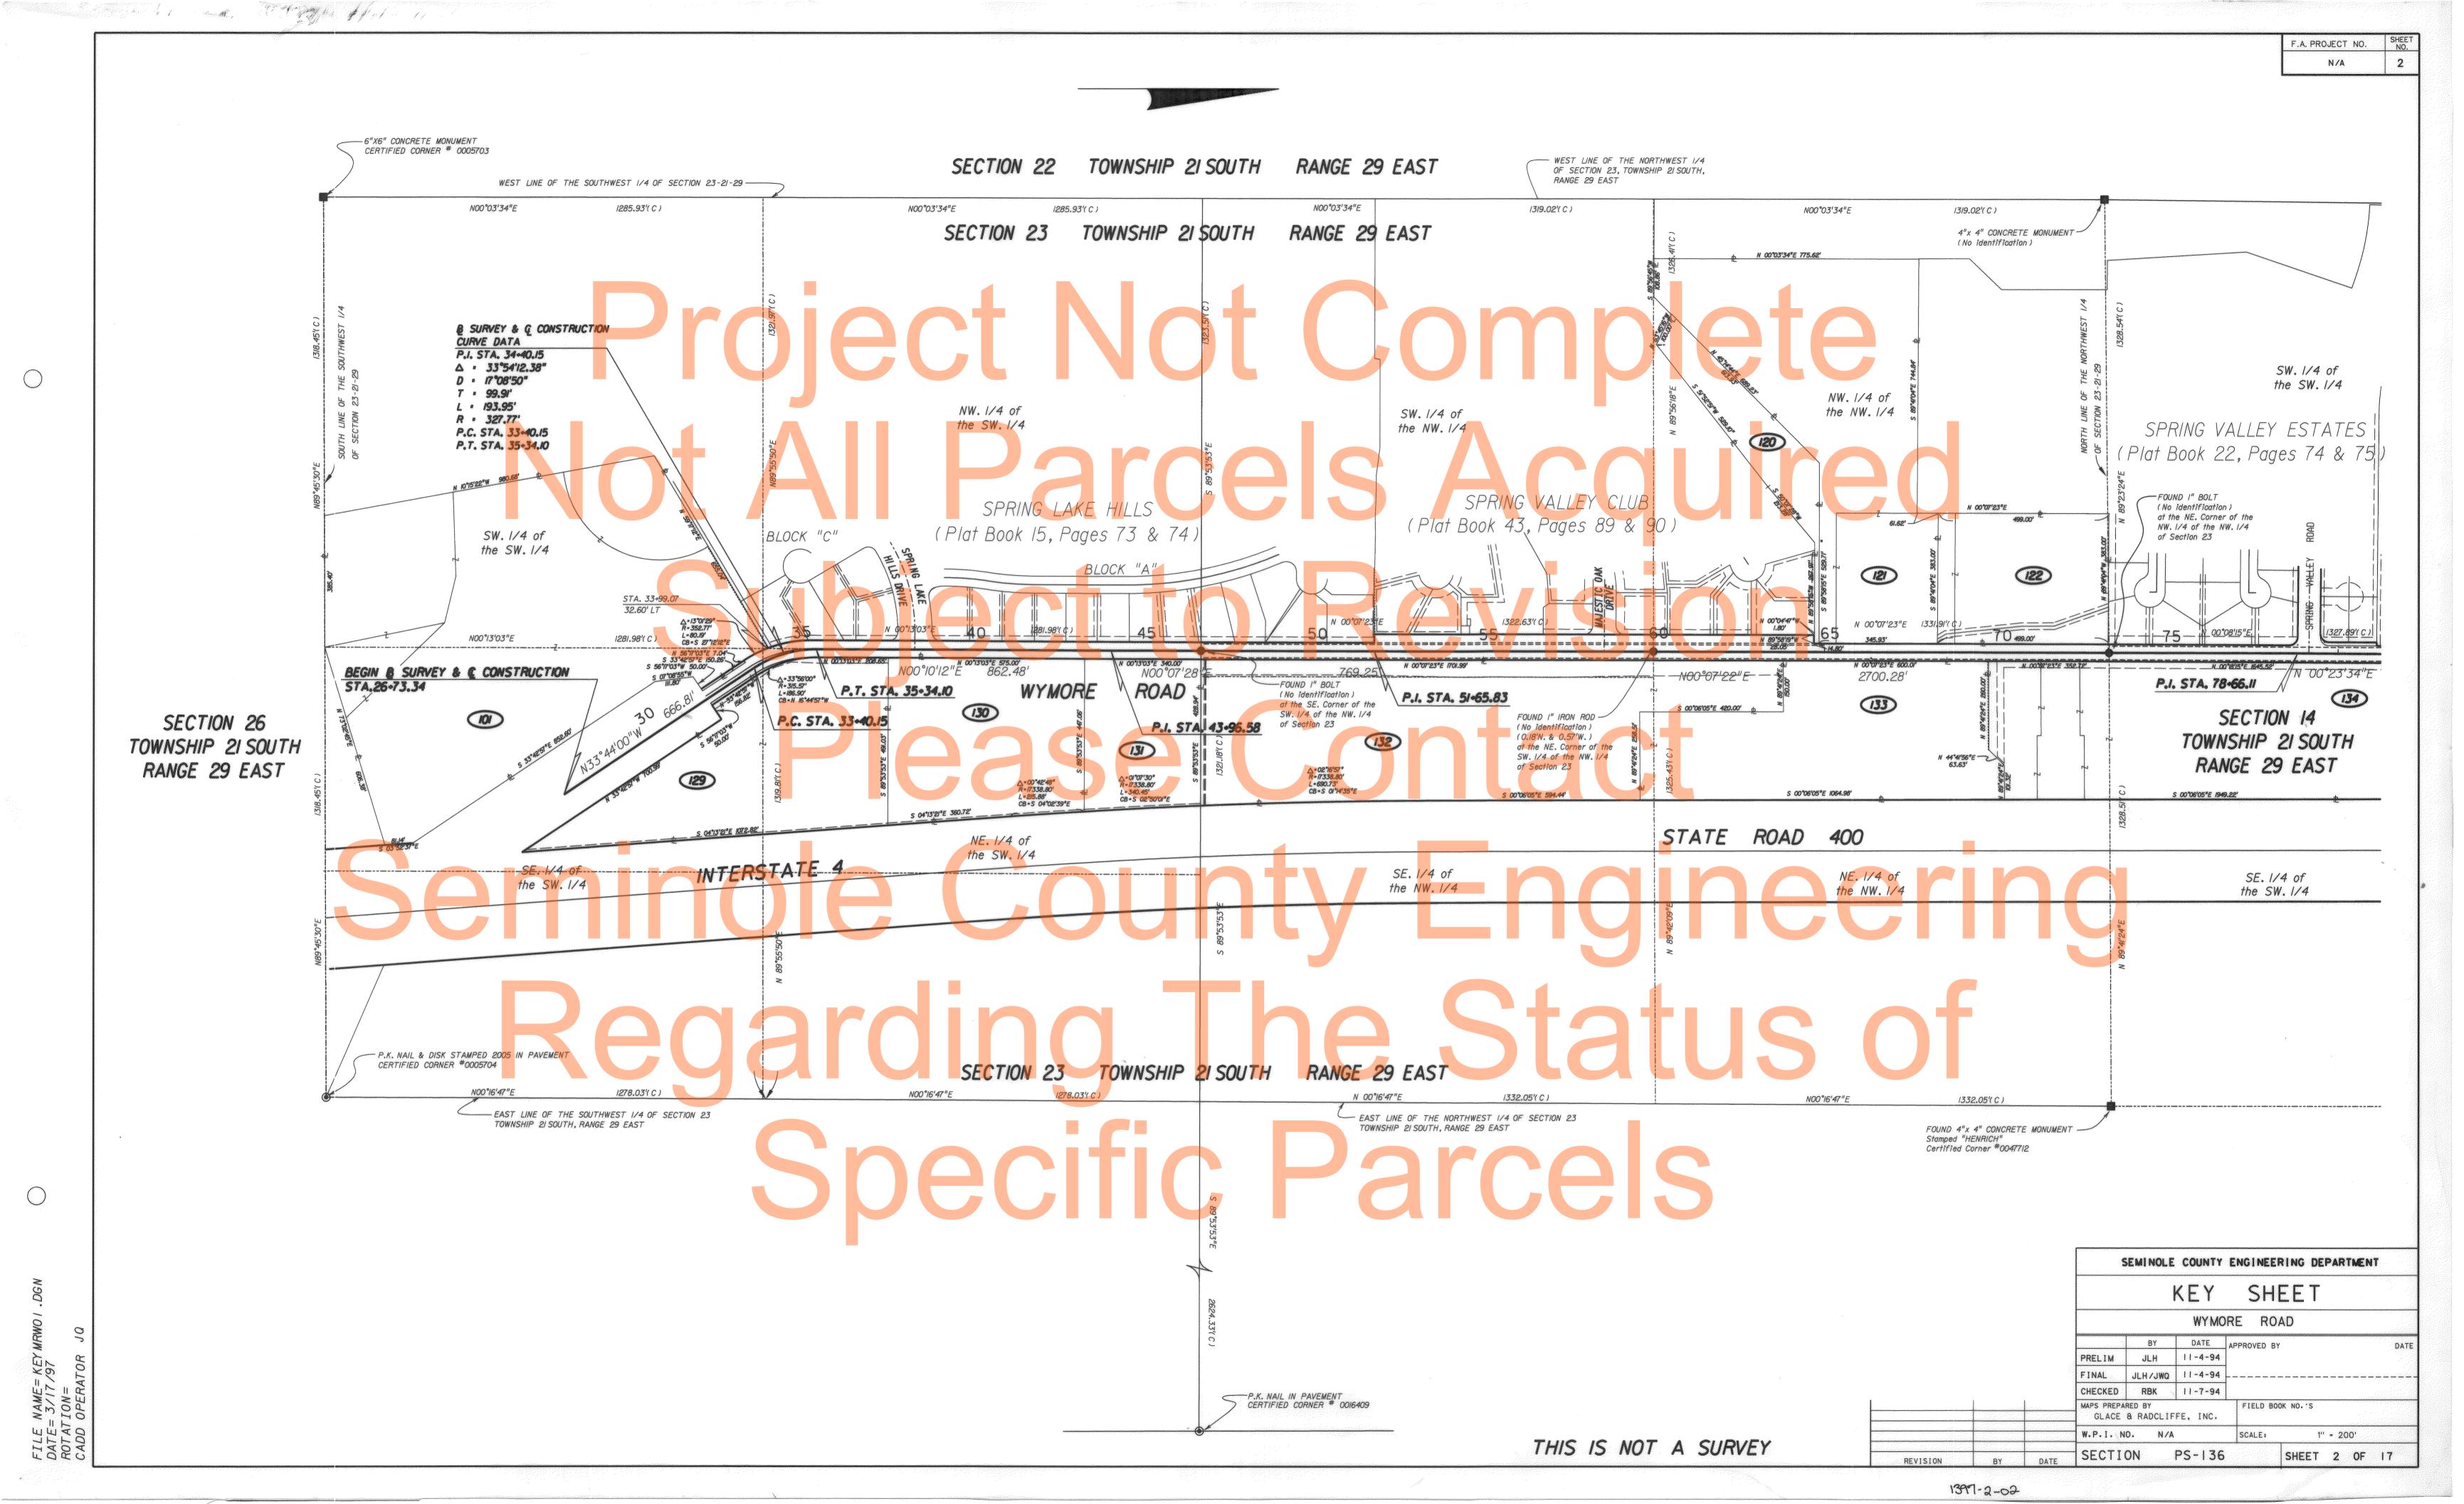


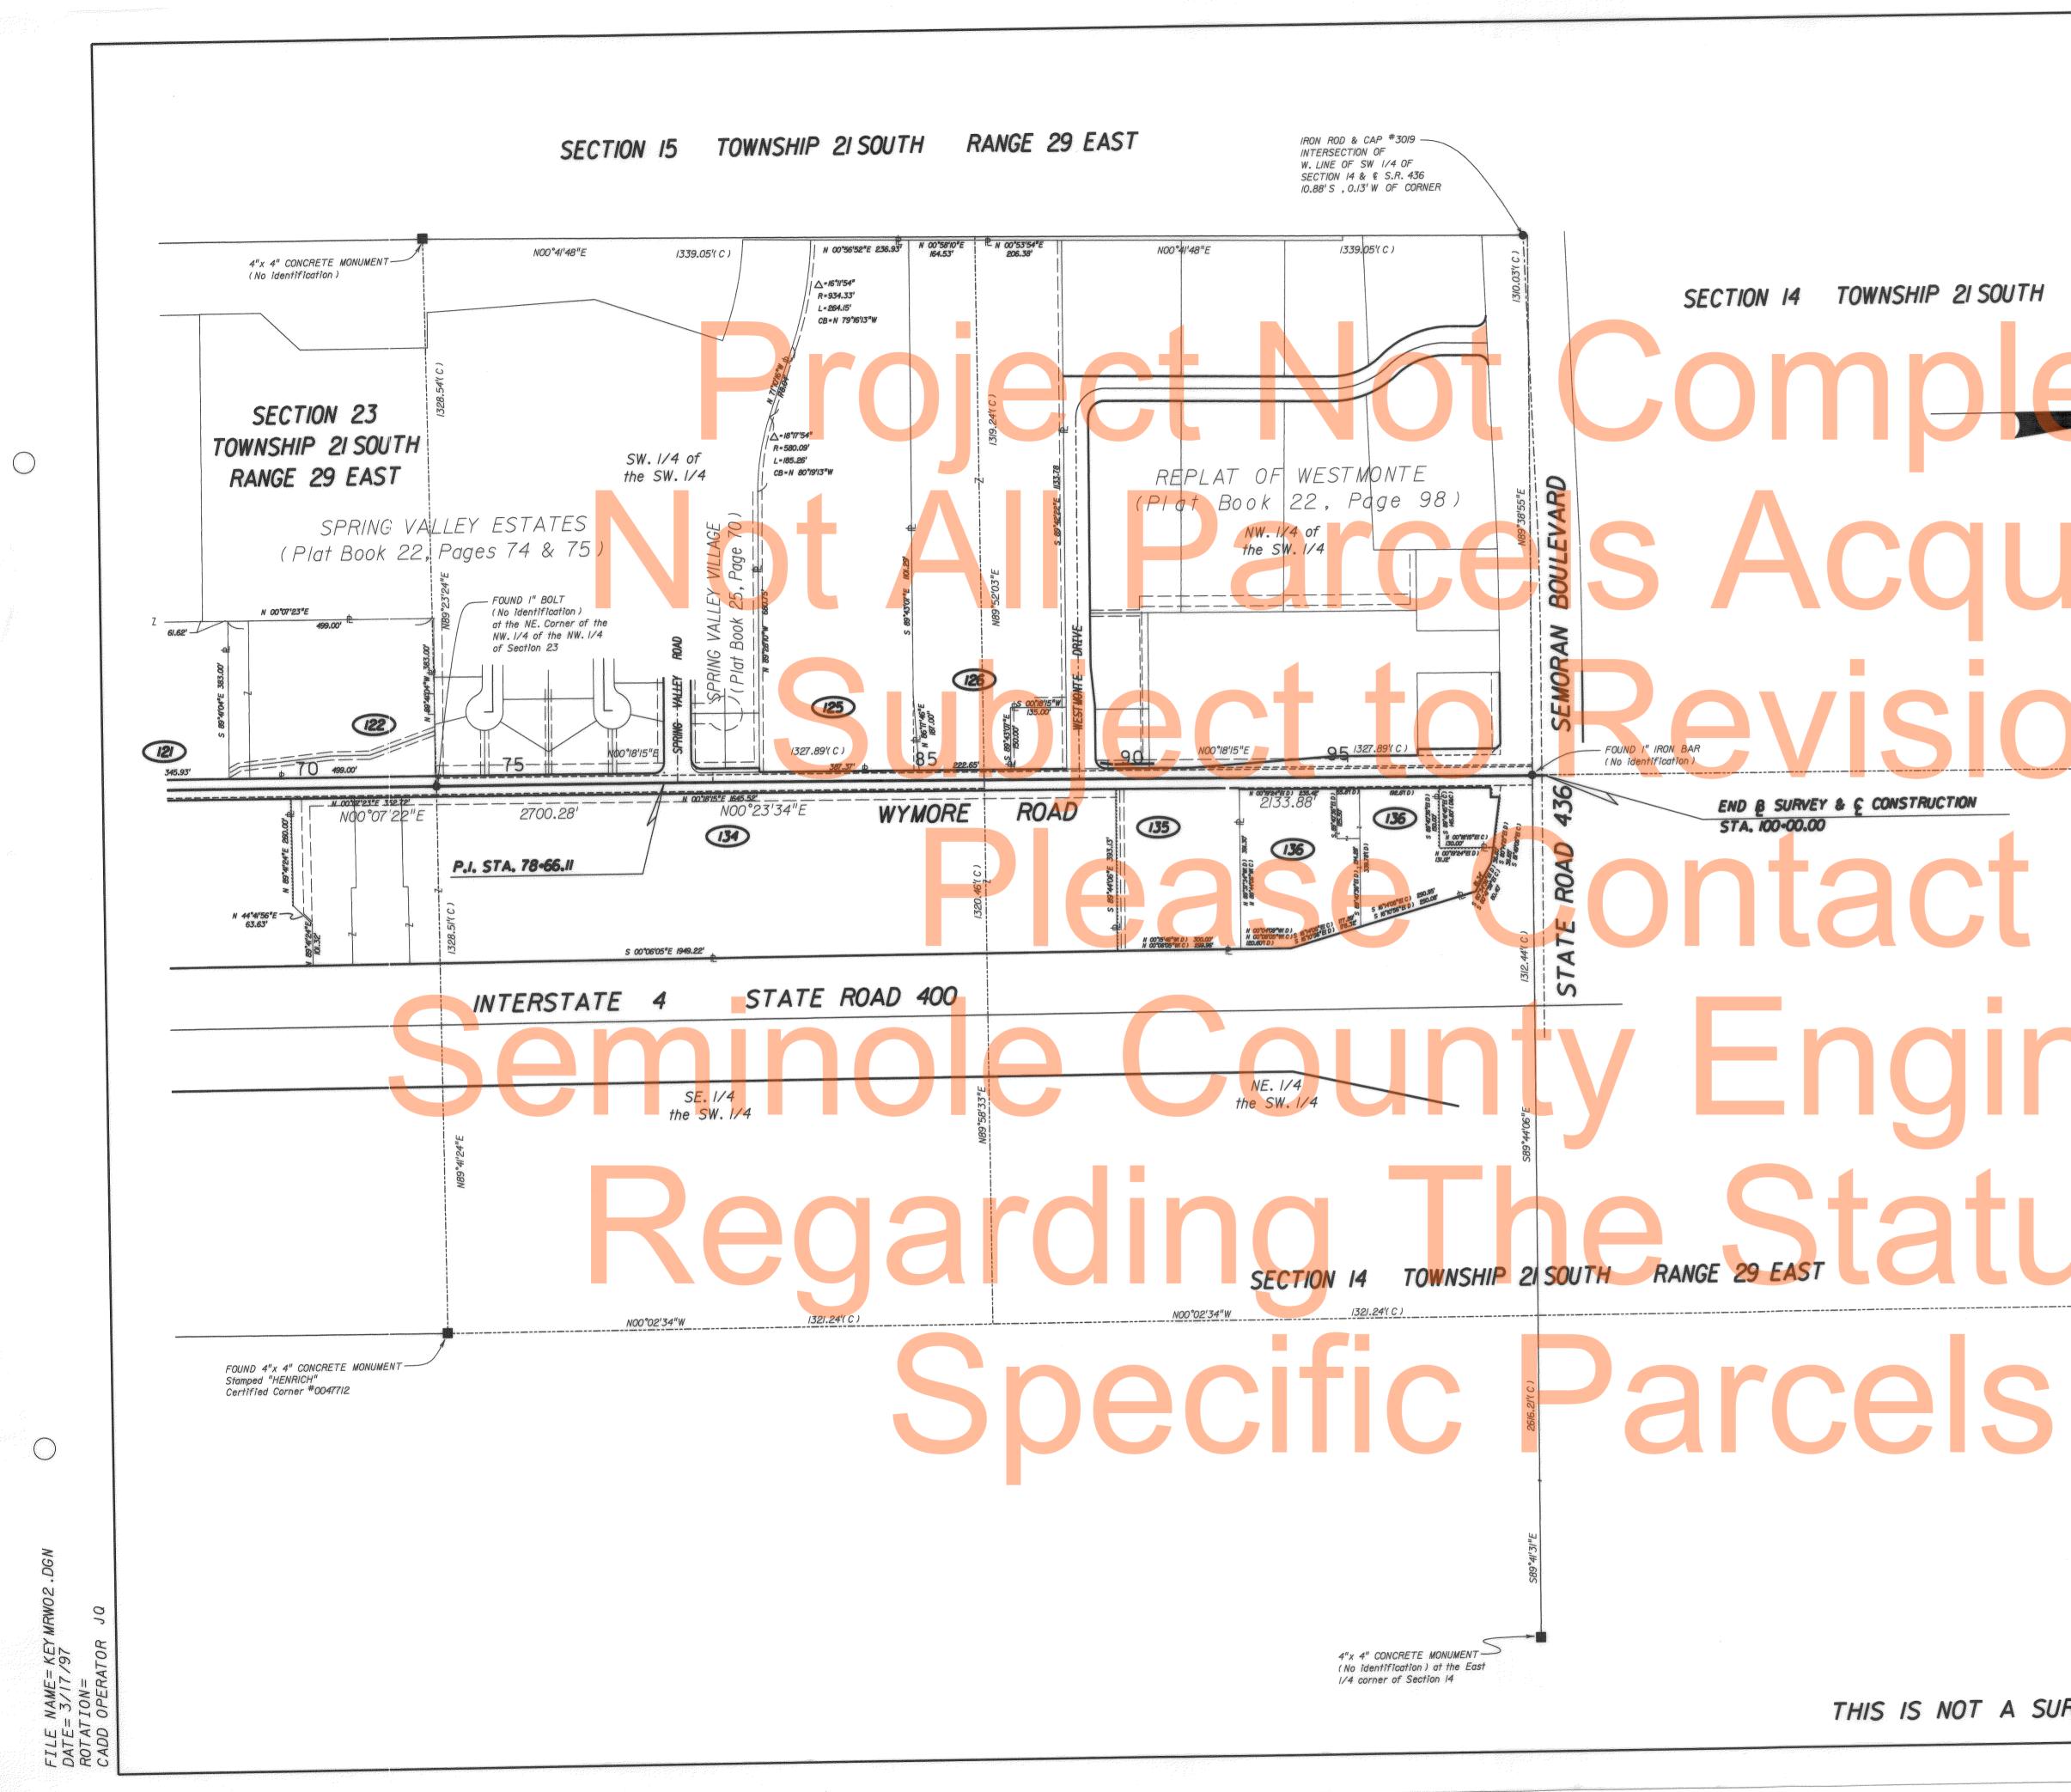


						F.A. PROJECT	NO. SHEET NO.	
						N/A	NO. NO. 3	
				彩				
DANCE OD EACT								
RANGE 29 EAST								
OTO								
			N.					
_	_							
JICe								
		unidade que poe realista des vels mandada das suas man	nin ilar farfannin de var ikkense an ias anderen is	nar maaani na na maani ya na maani ya na maana na na maana na na maa				
						ato ,		
	n water en en maan en en water er en mater en er erste en en state ei en state	n me dalama dia kai mangan dia ant antana dia a	n annar an an marrie an an annar an an an	An an an anns an an				
					ľ			
				SEMINO	LE COUNTY EN	GINEERING DEP	ARTMENT	
					KEY	SHEET		
						ROAD		
				BY PRELIM JLH		PROVED BY	(	DATE
				FINAL JLH/JI	WQ 11-4-94	ndala dalar alar dalar naka naka naka naka naka naka naka na		
				CHECKED RBK MAPS PREPARED BY GLACE & RADCI	in the second	FIELD BOOK NO.'S		
SURVEY				W.P.1. NO. 1	N/A		- 200'	
	REVISION	ВҮ	DATE	SECTION	PS-136	SHEET	3 OF 17	

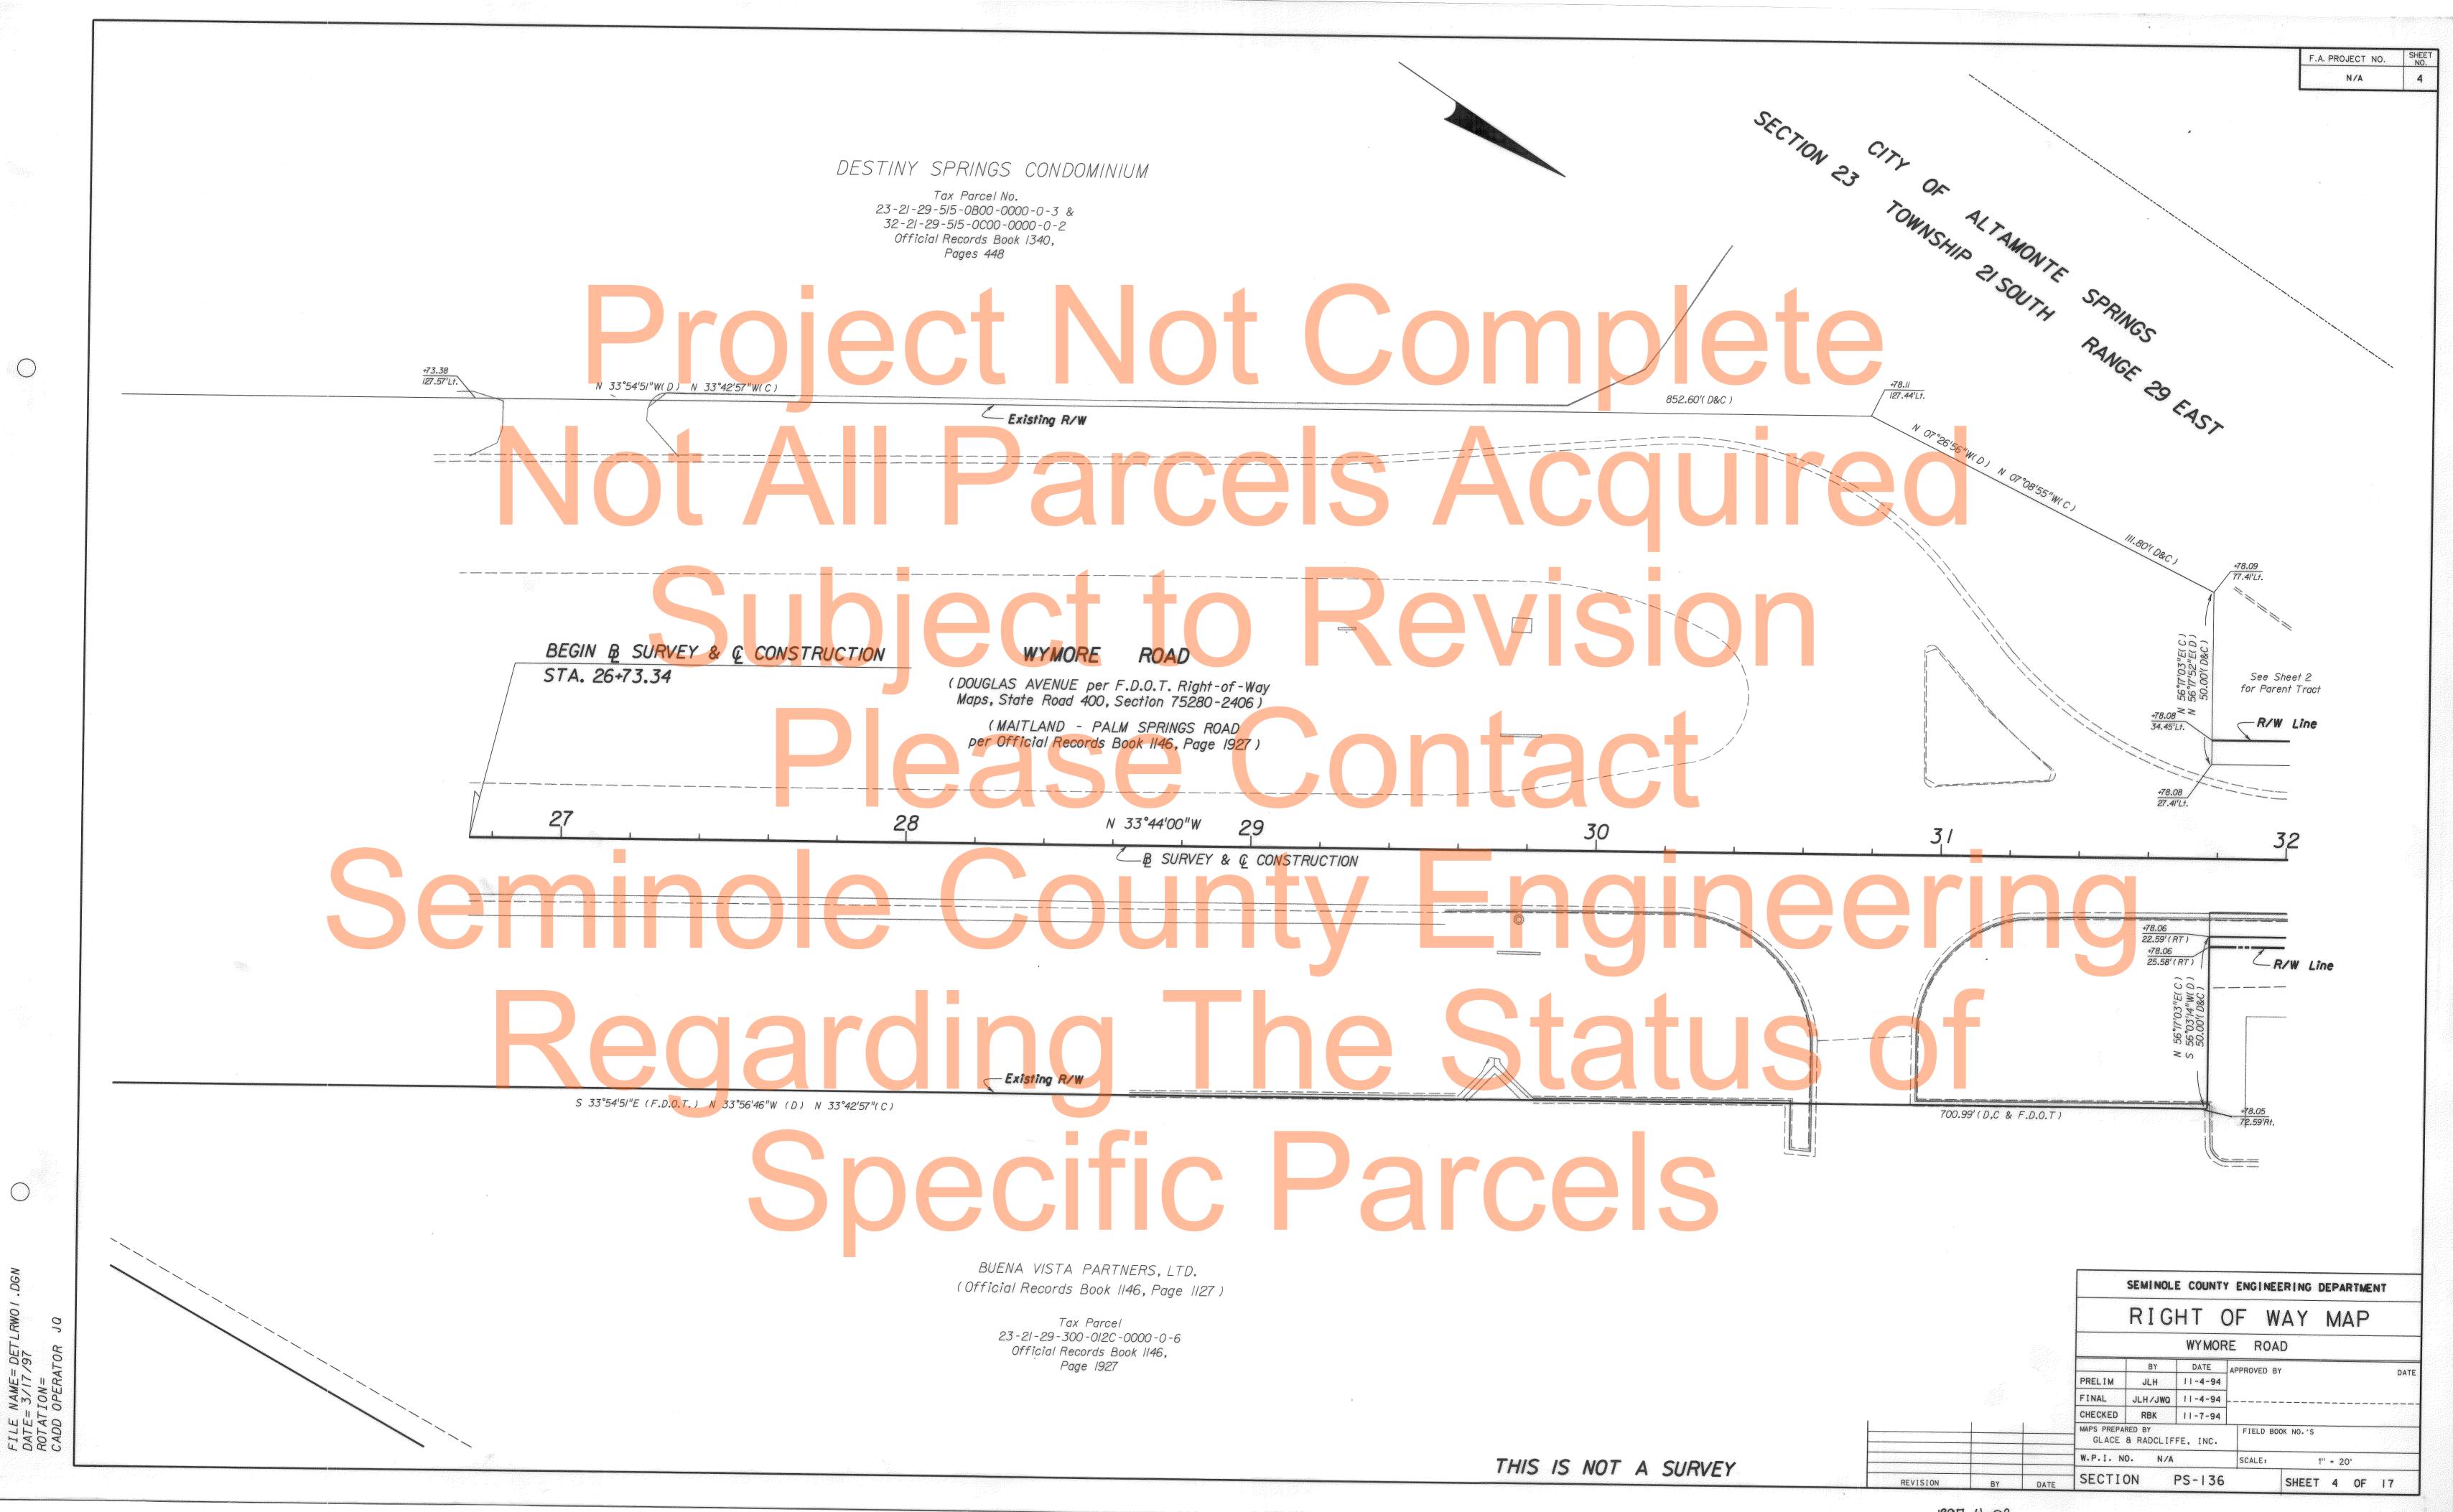


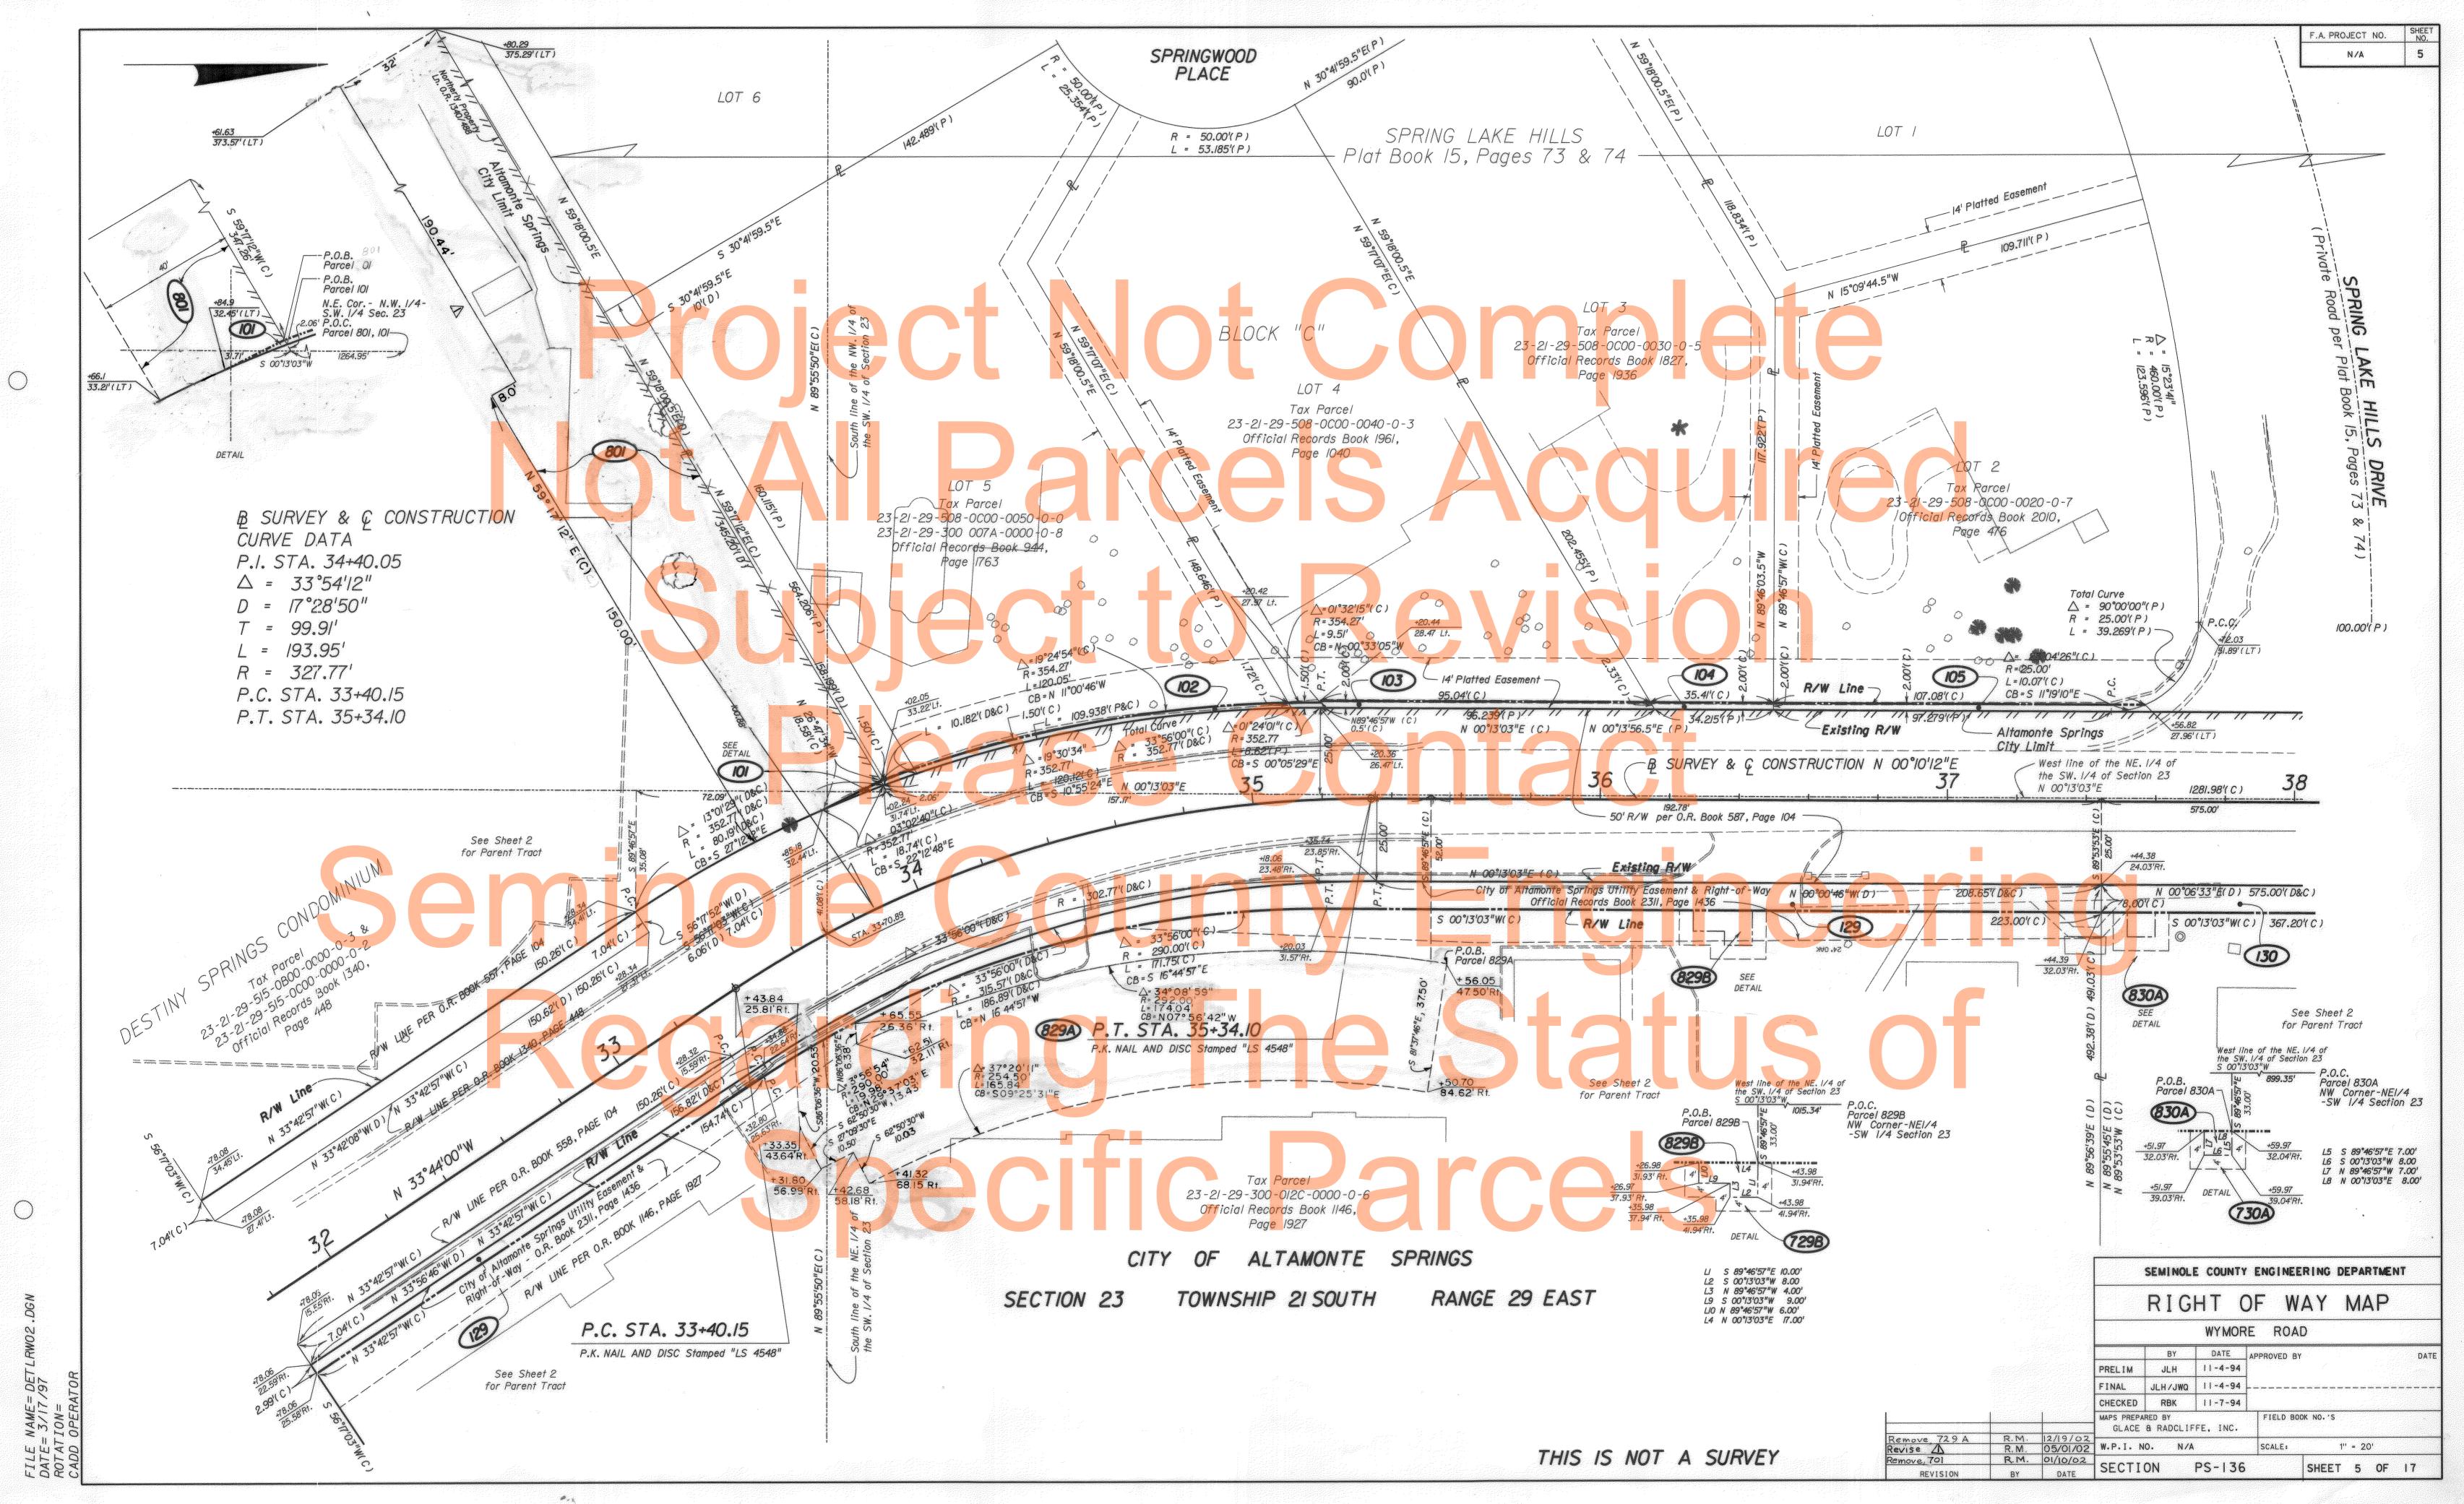

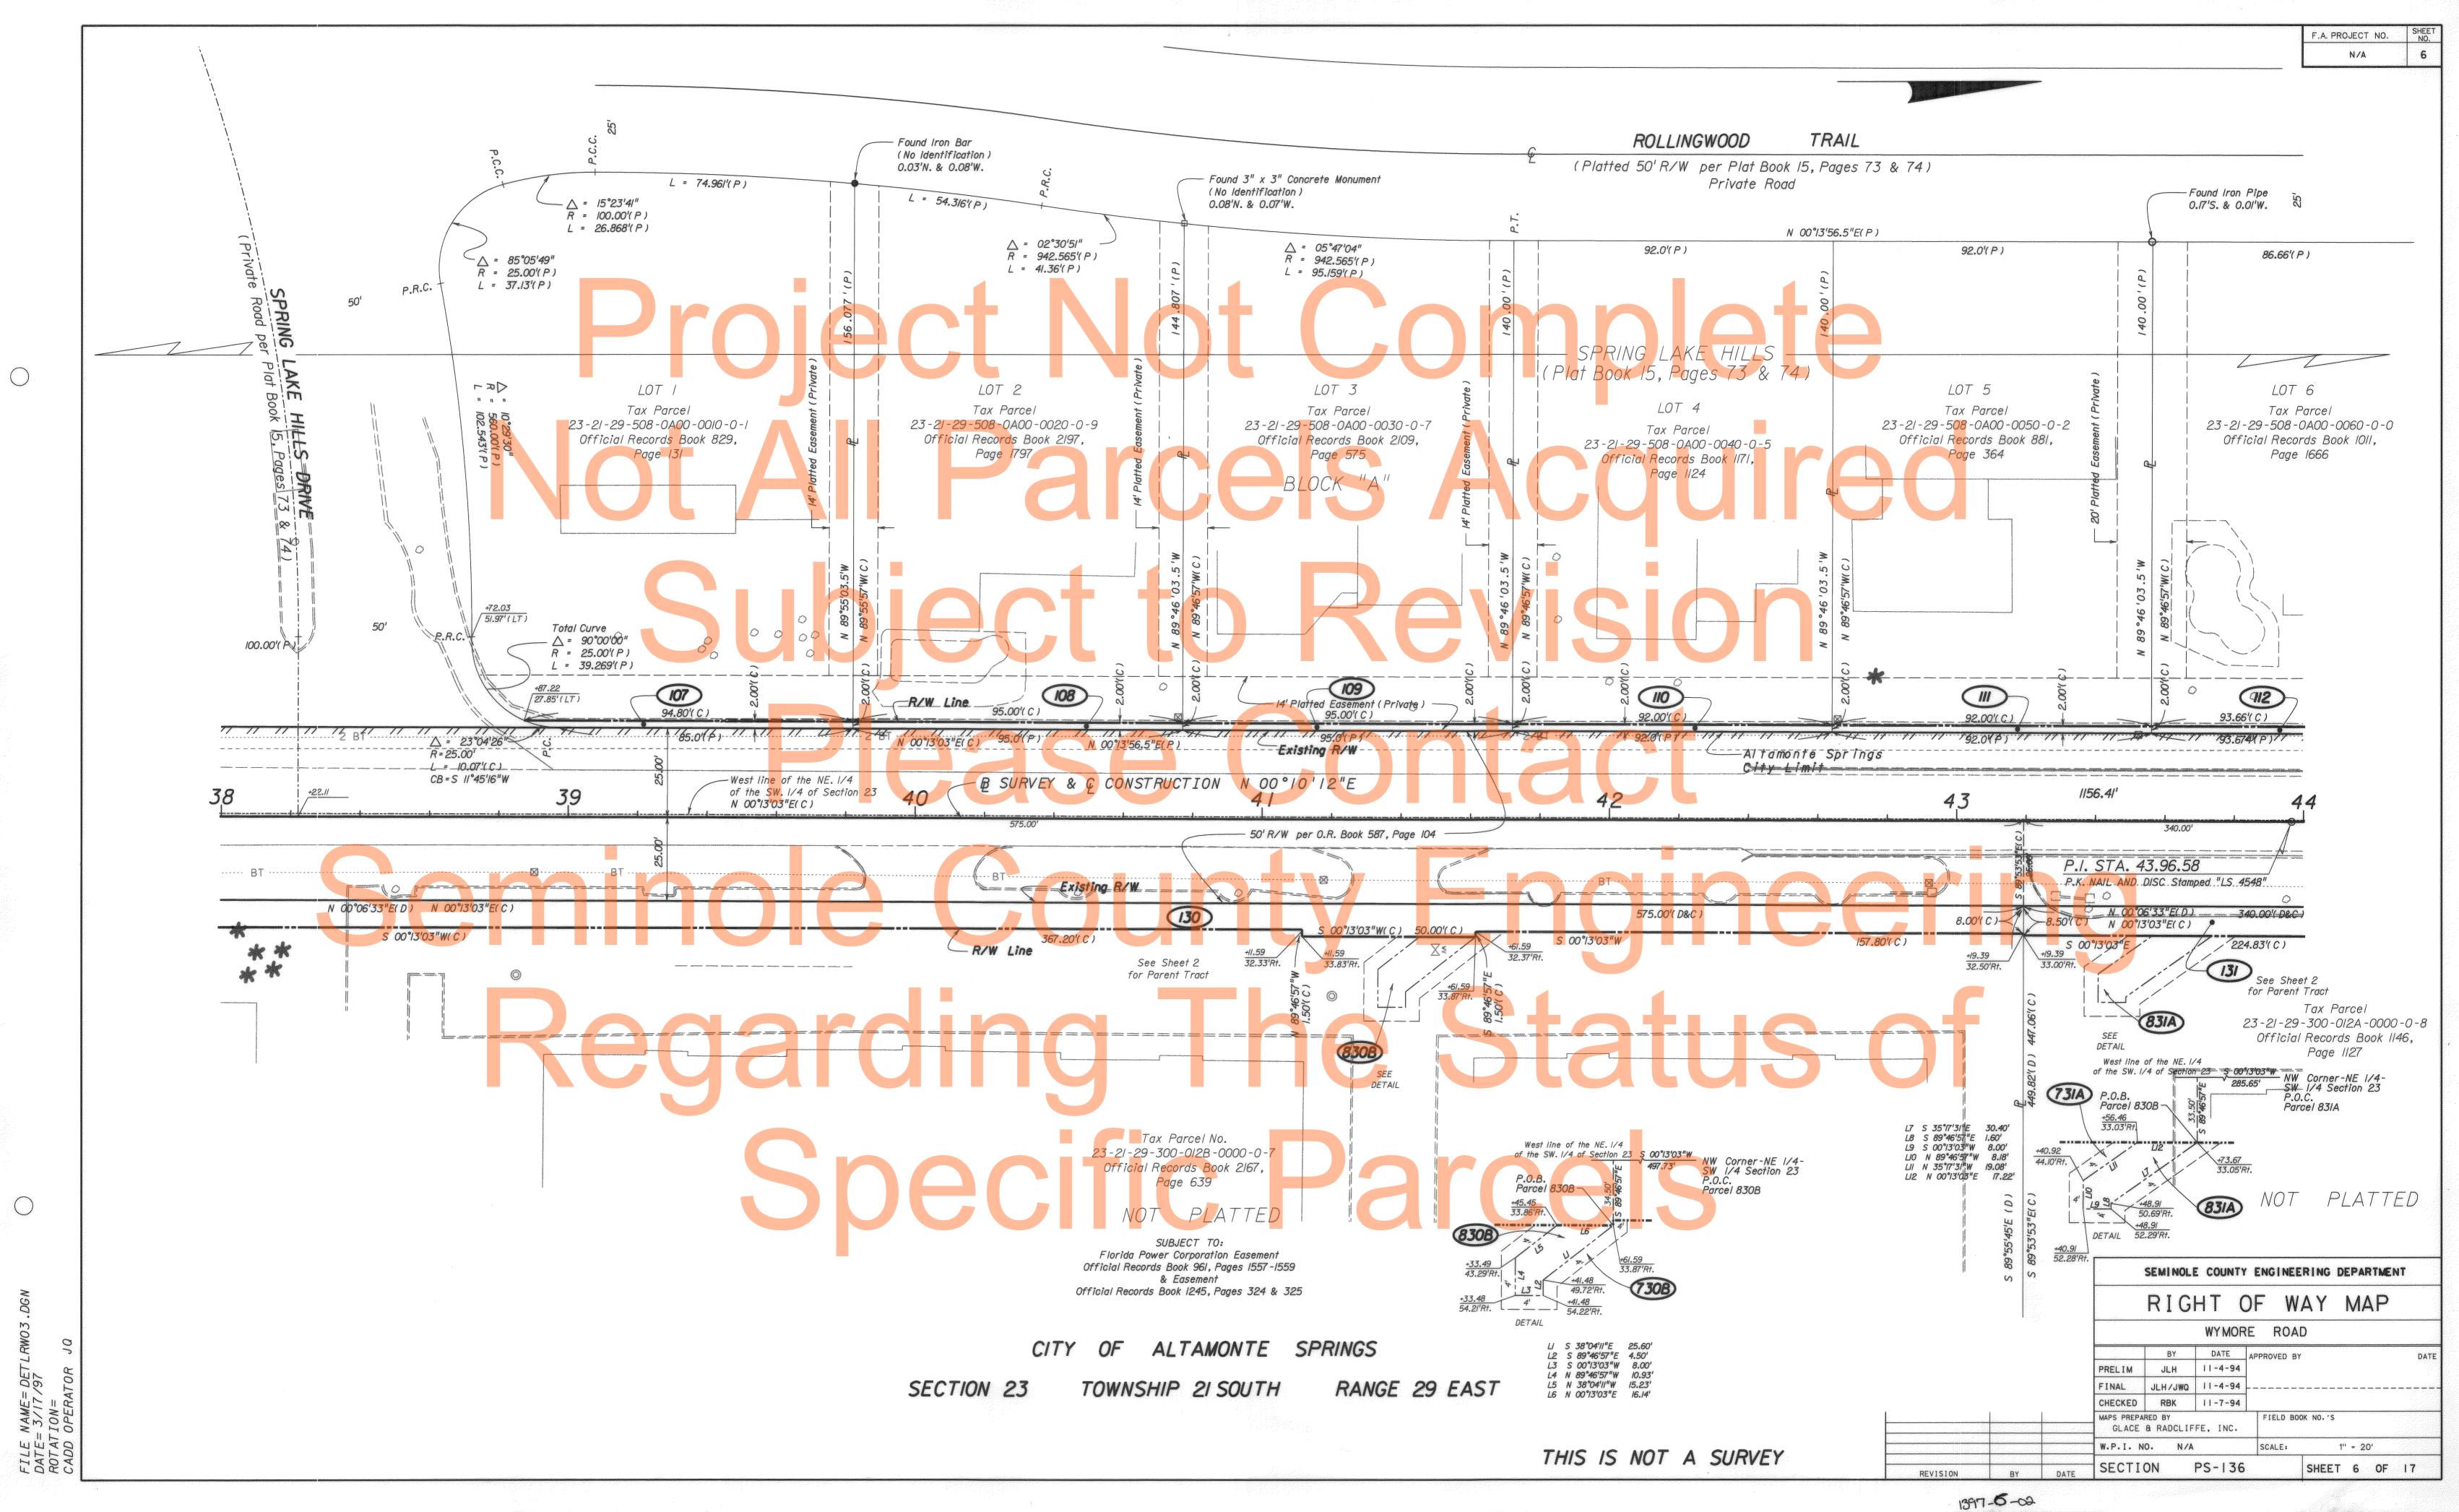

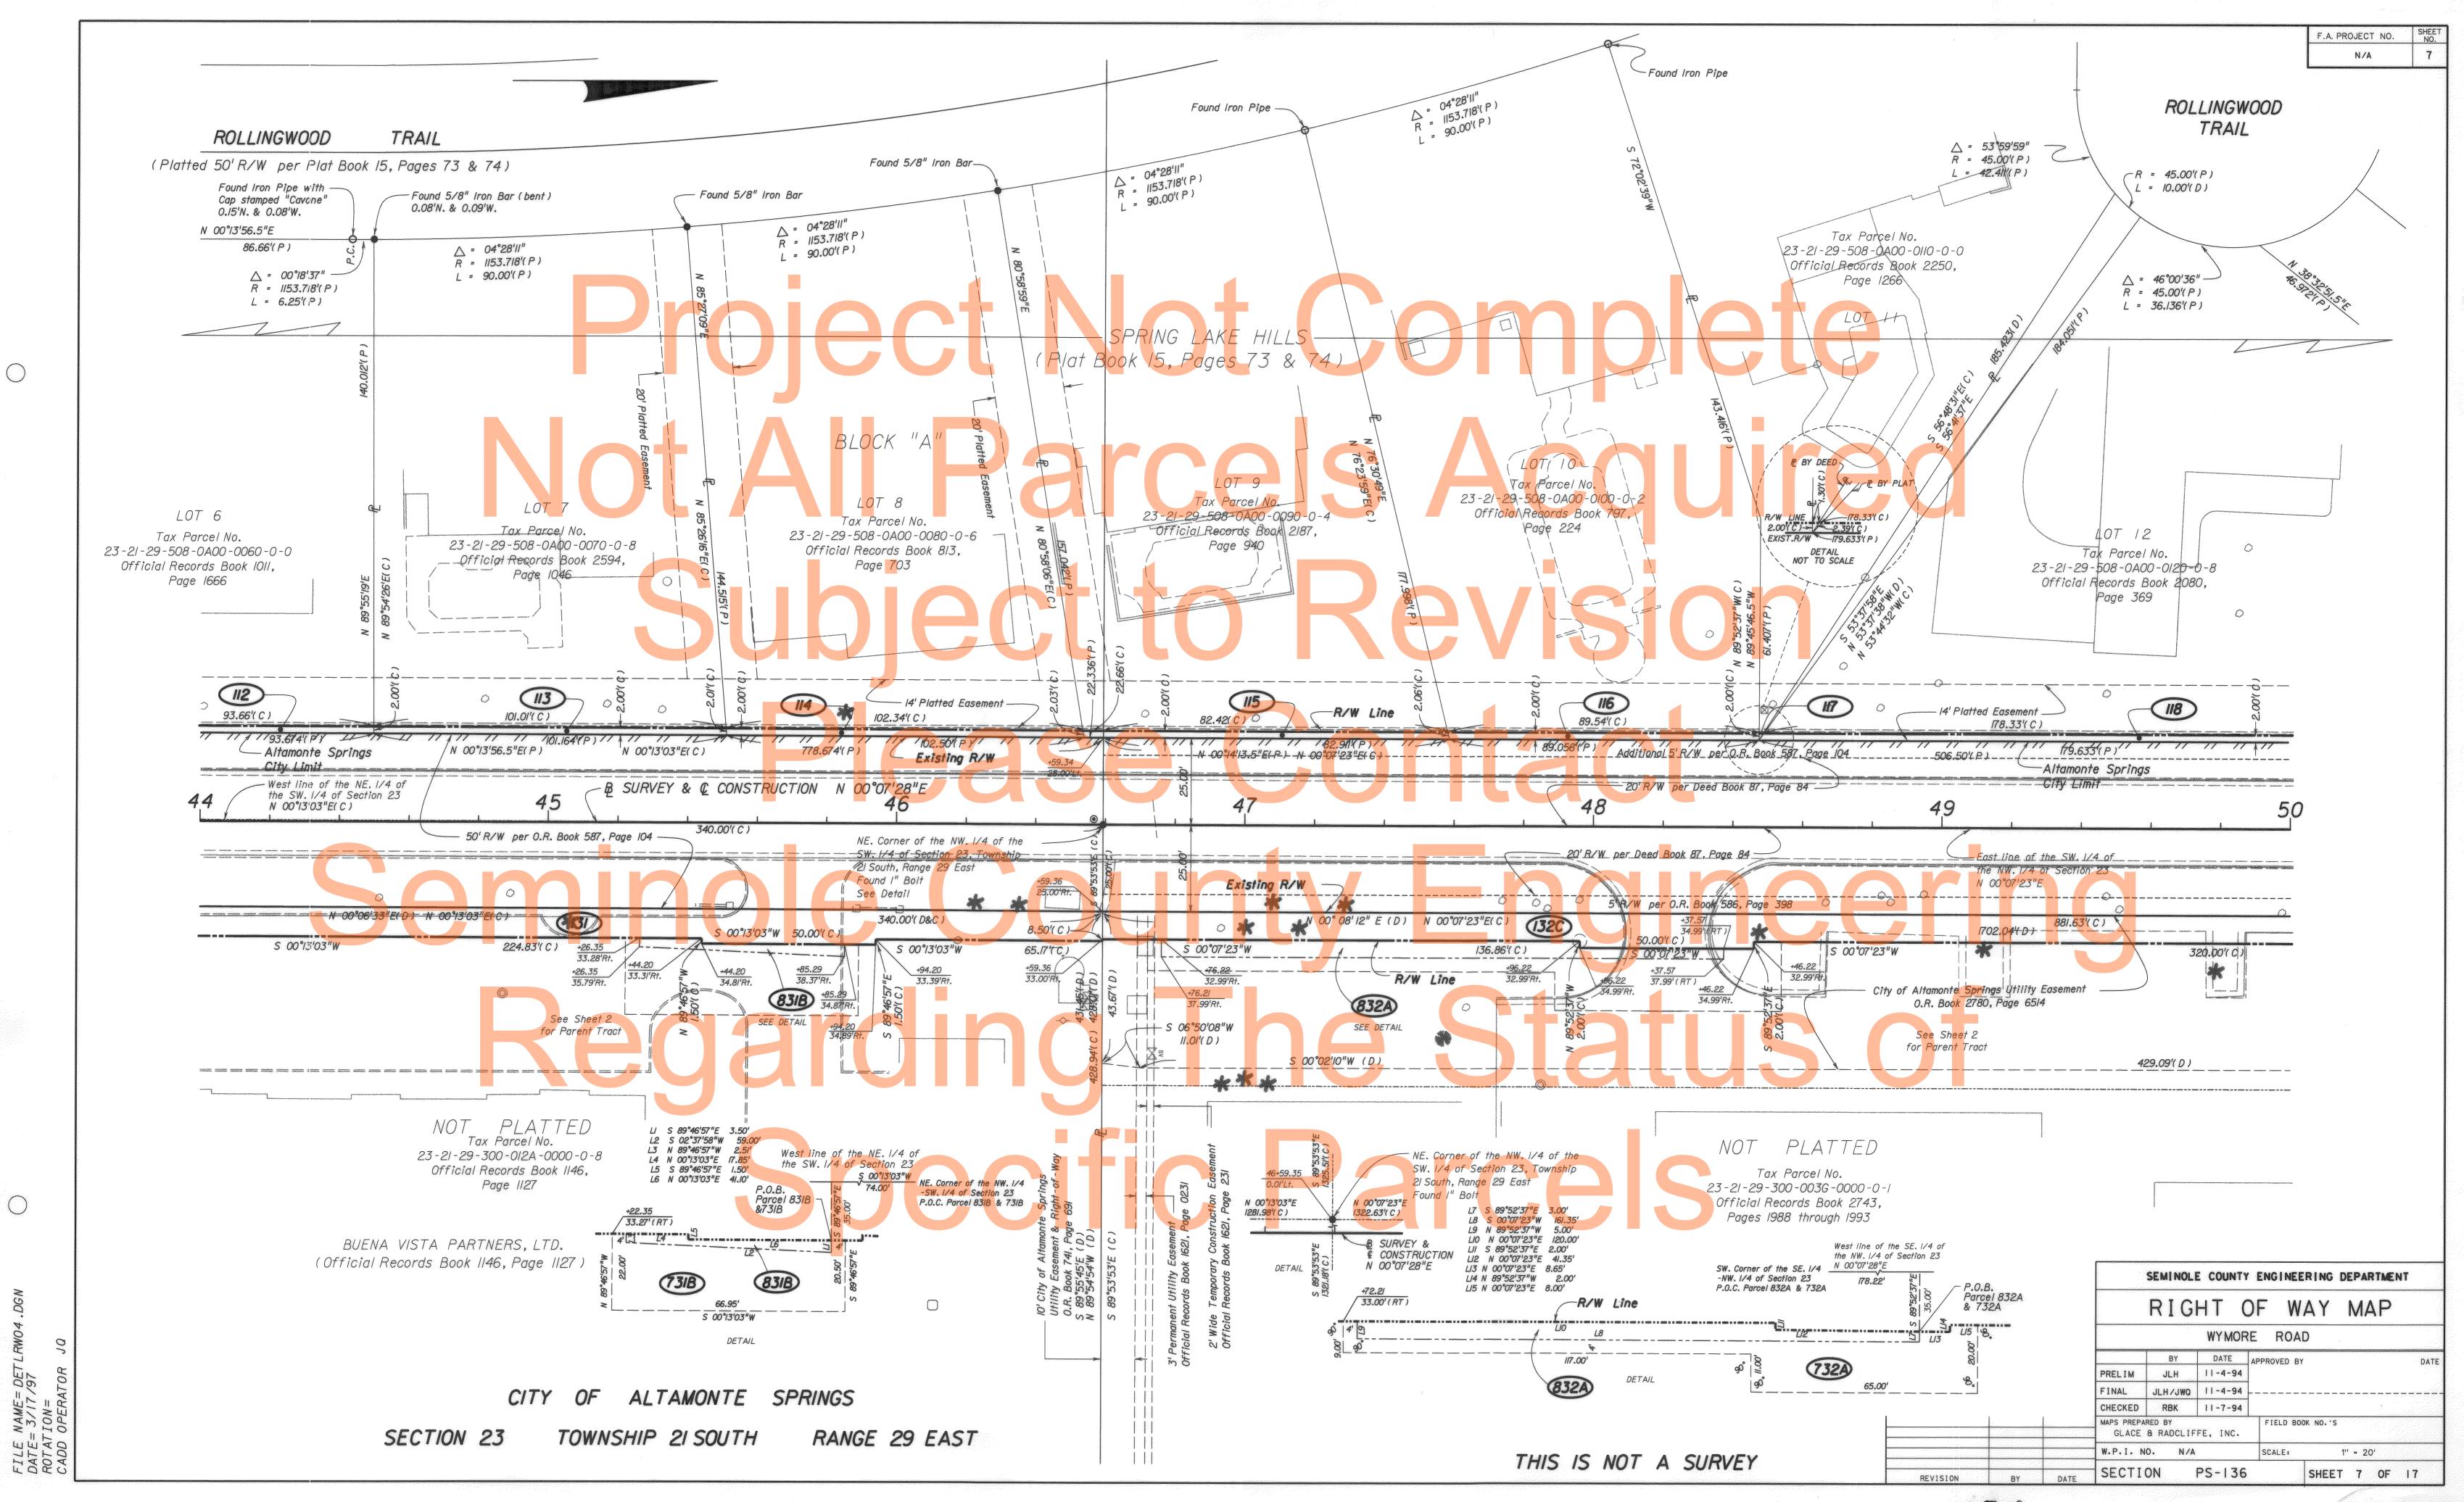

1397-0-02

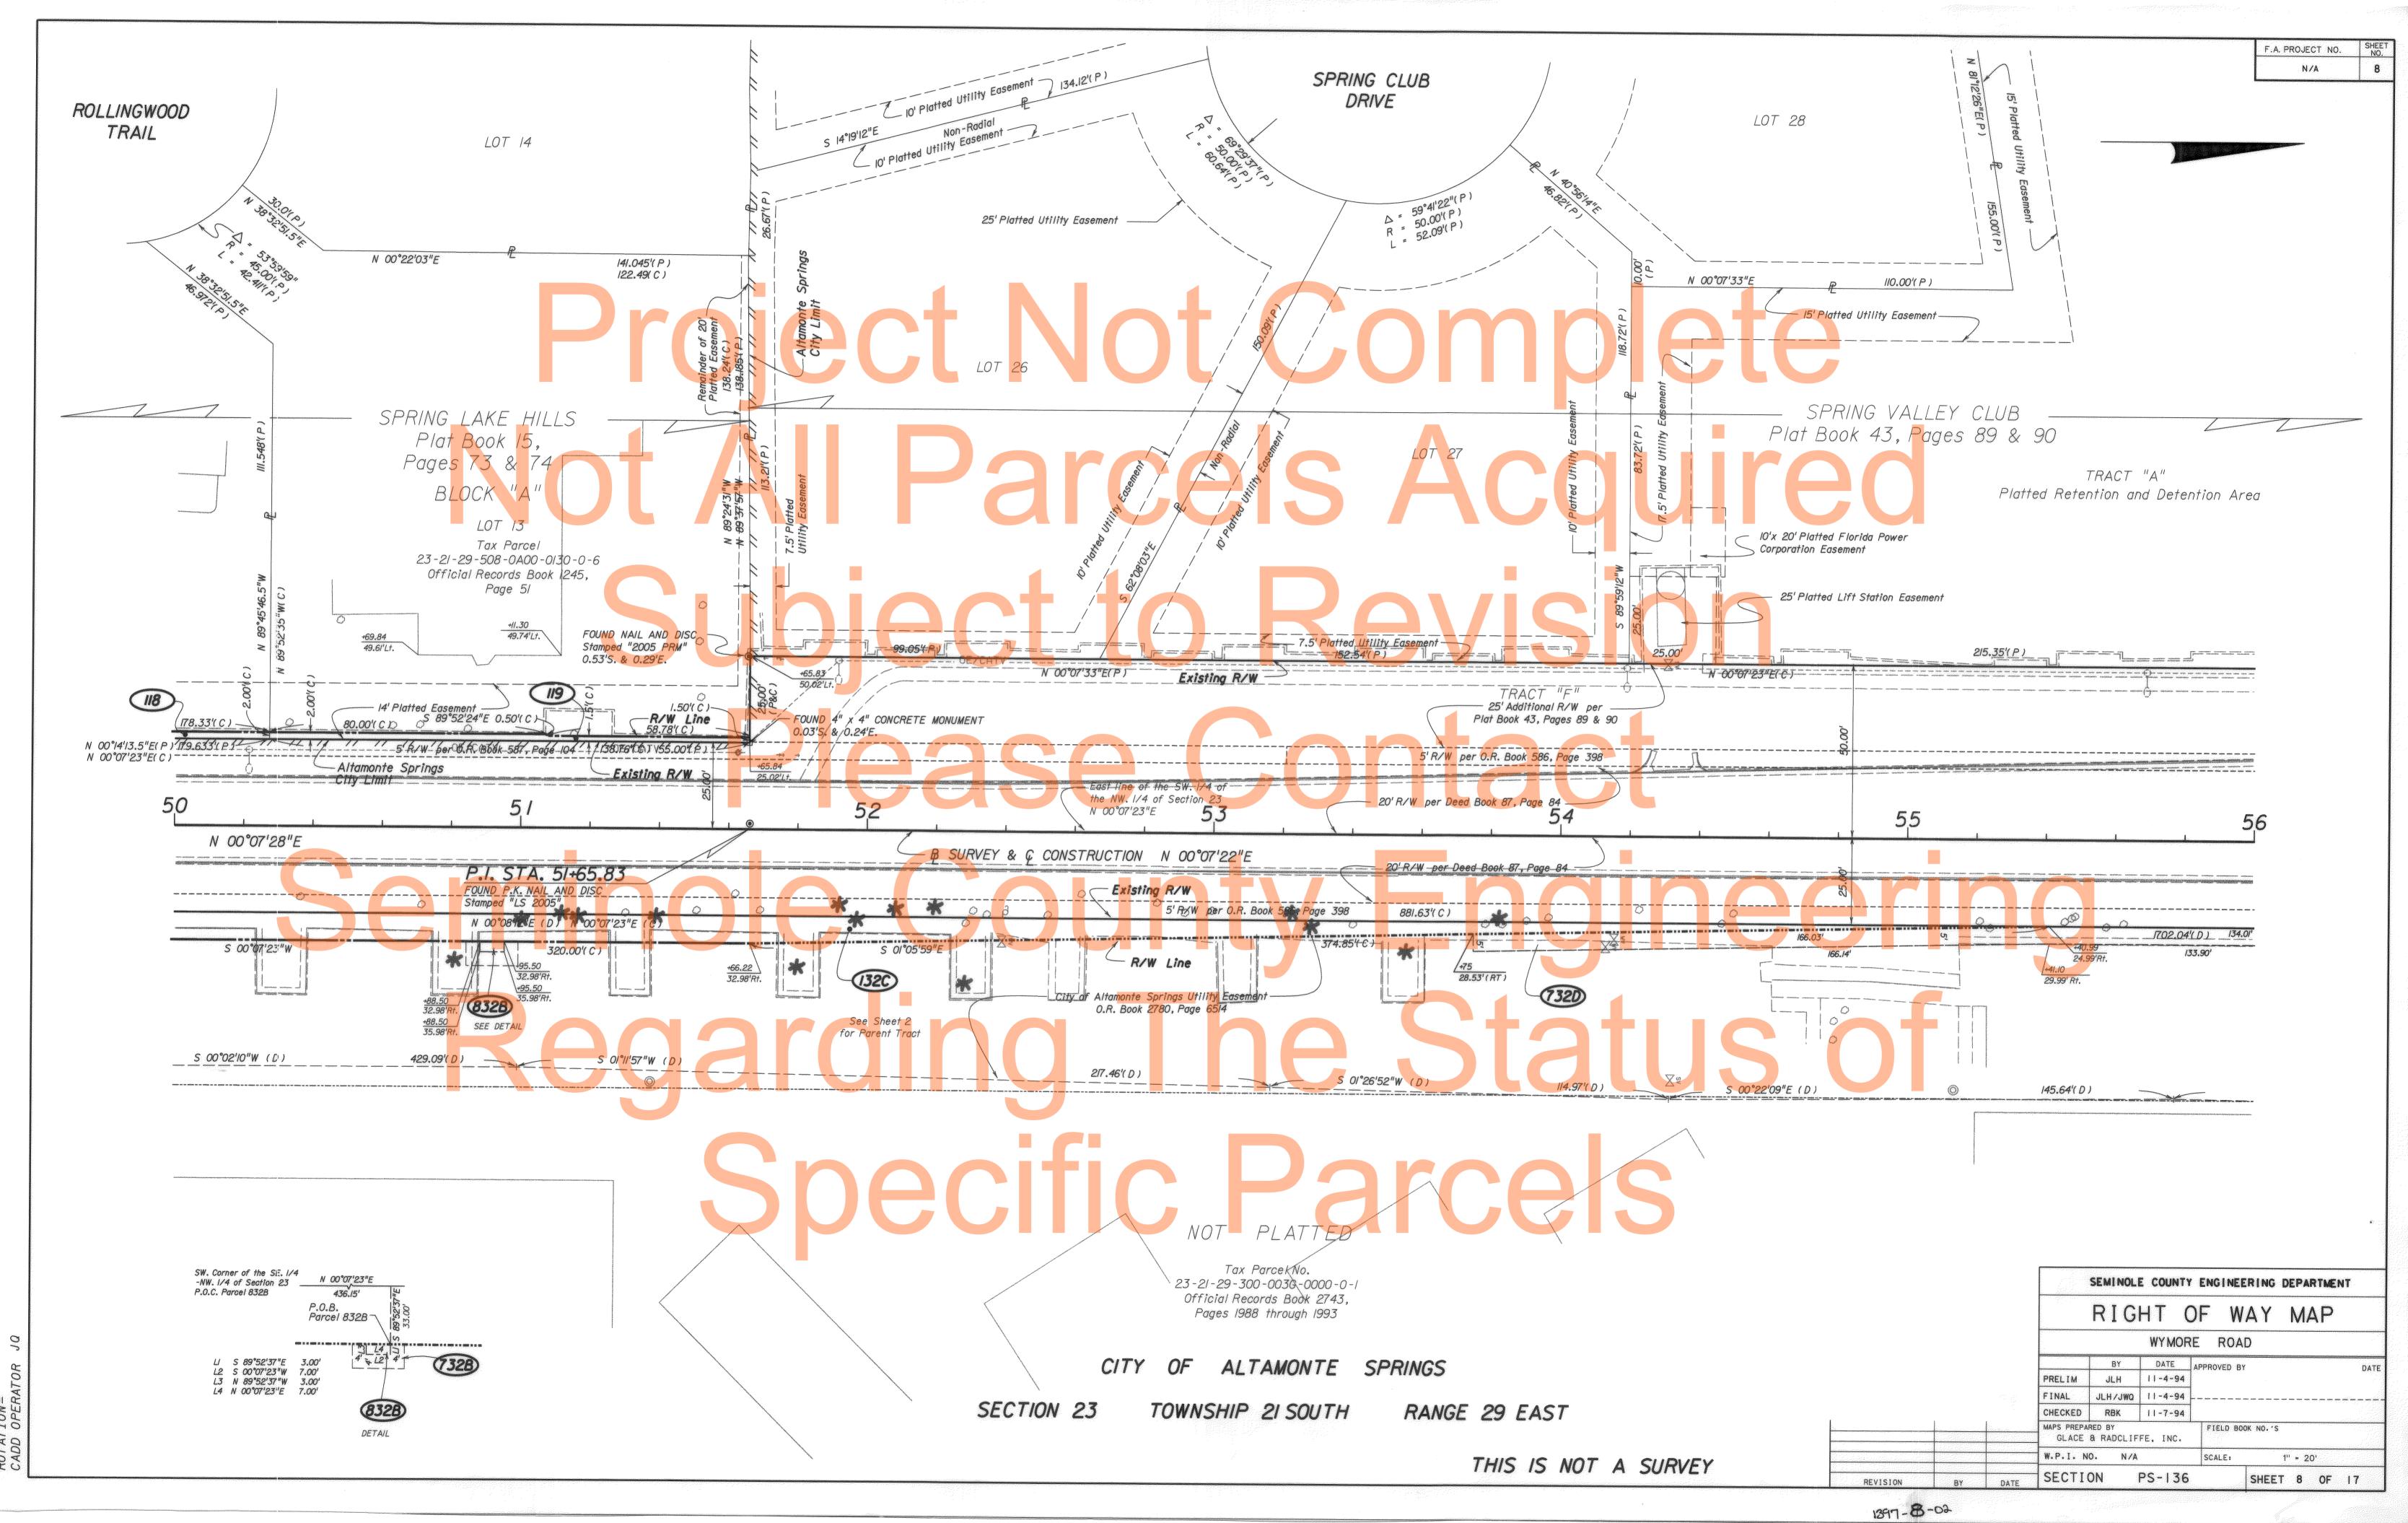



DG


5


 $\bigcirc$ 

NAME= DET = 3/17/97 \_\_\_\_\_\_ 9 FILE I DATE= ROTAT CADD (

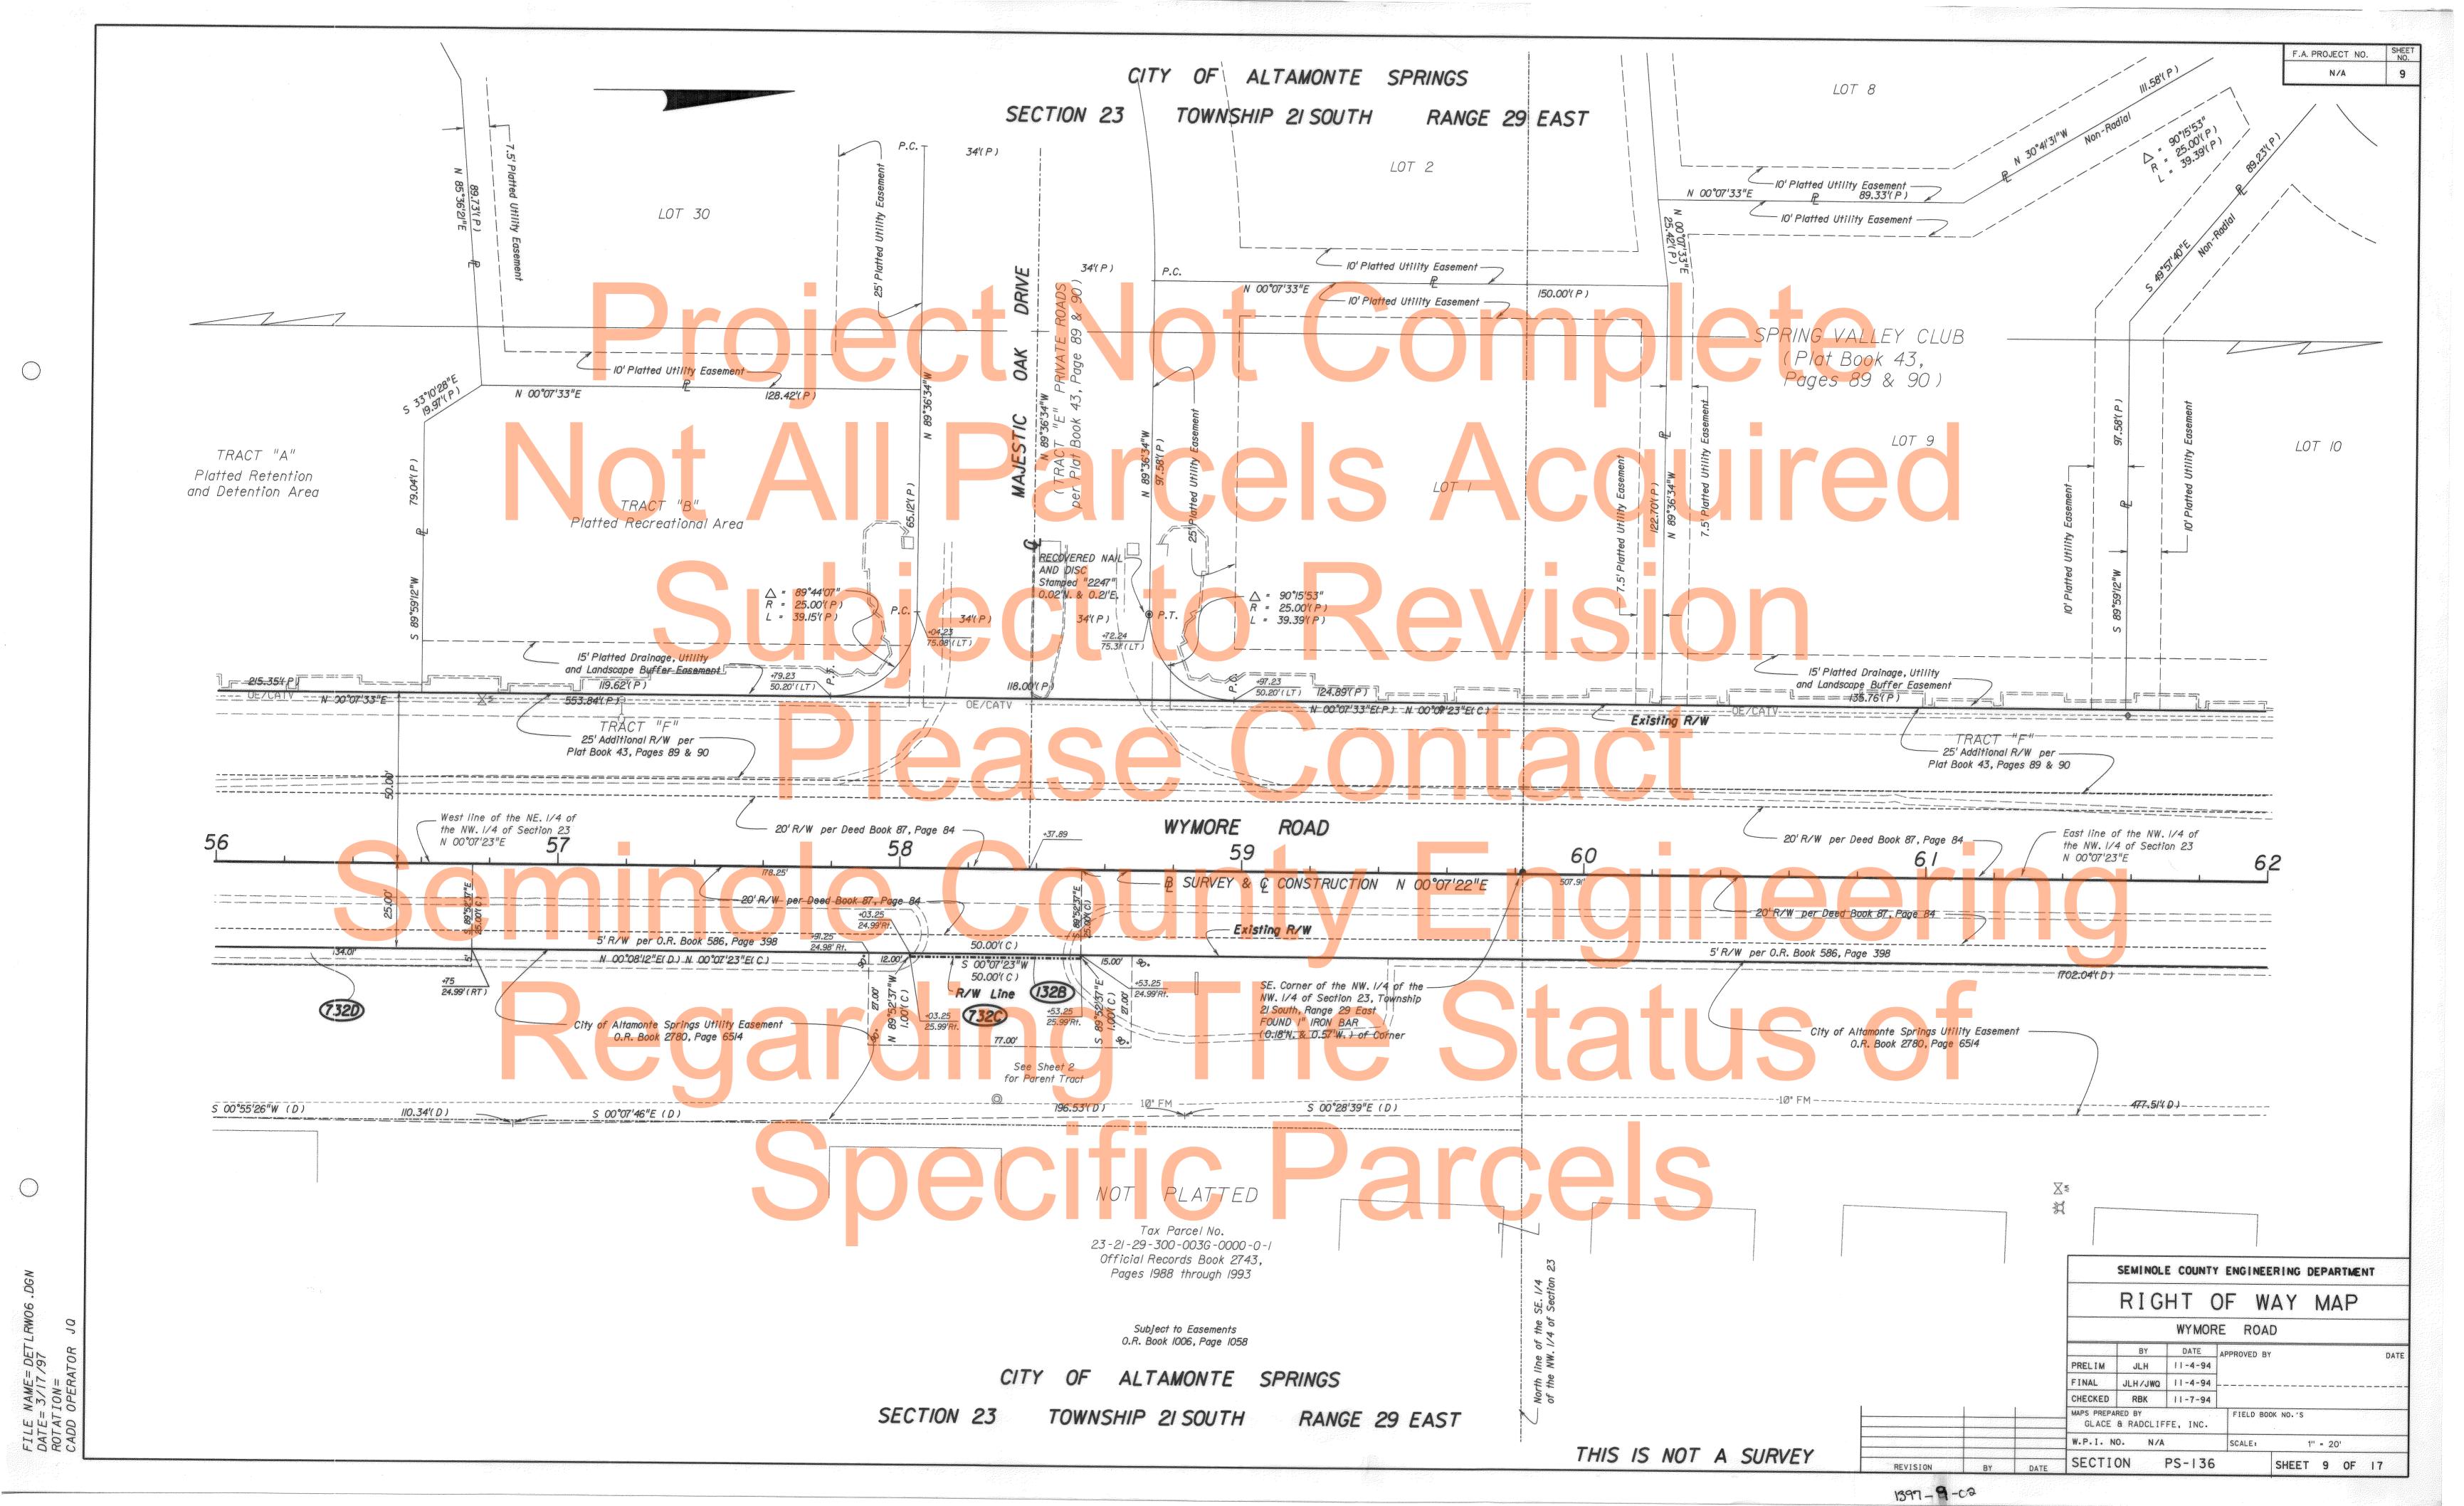

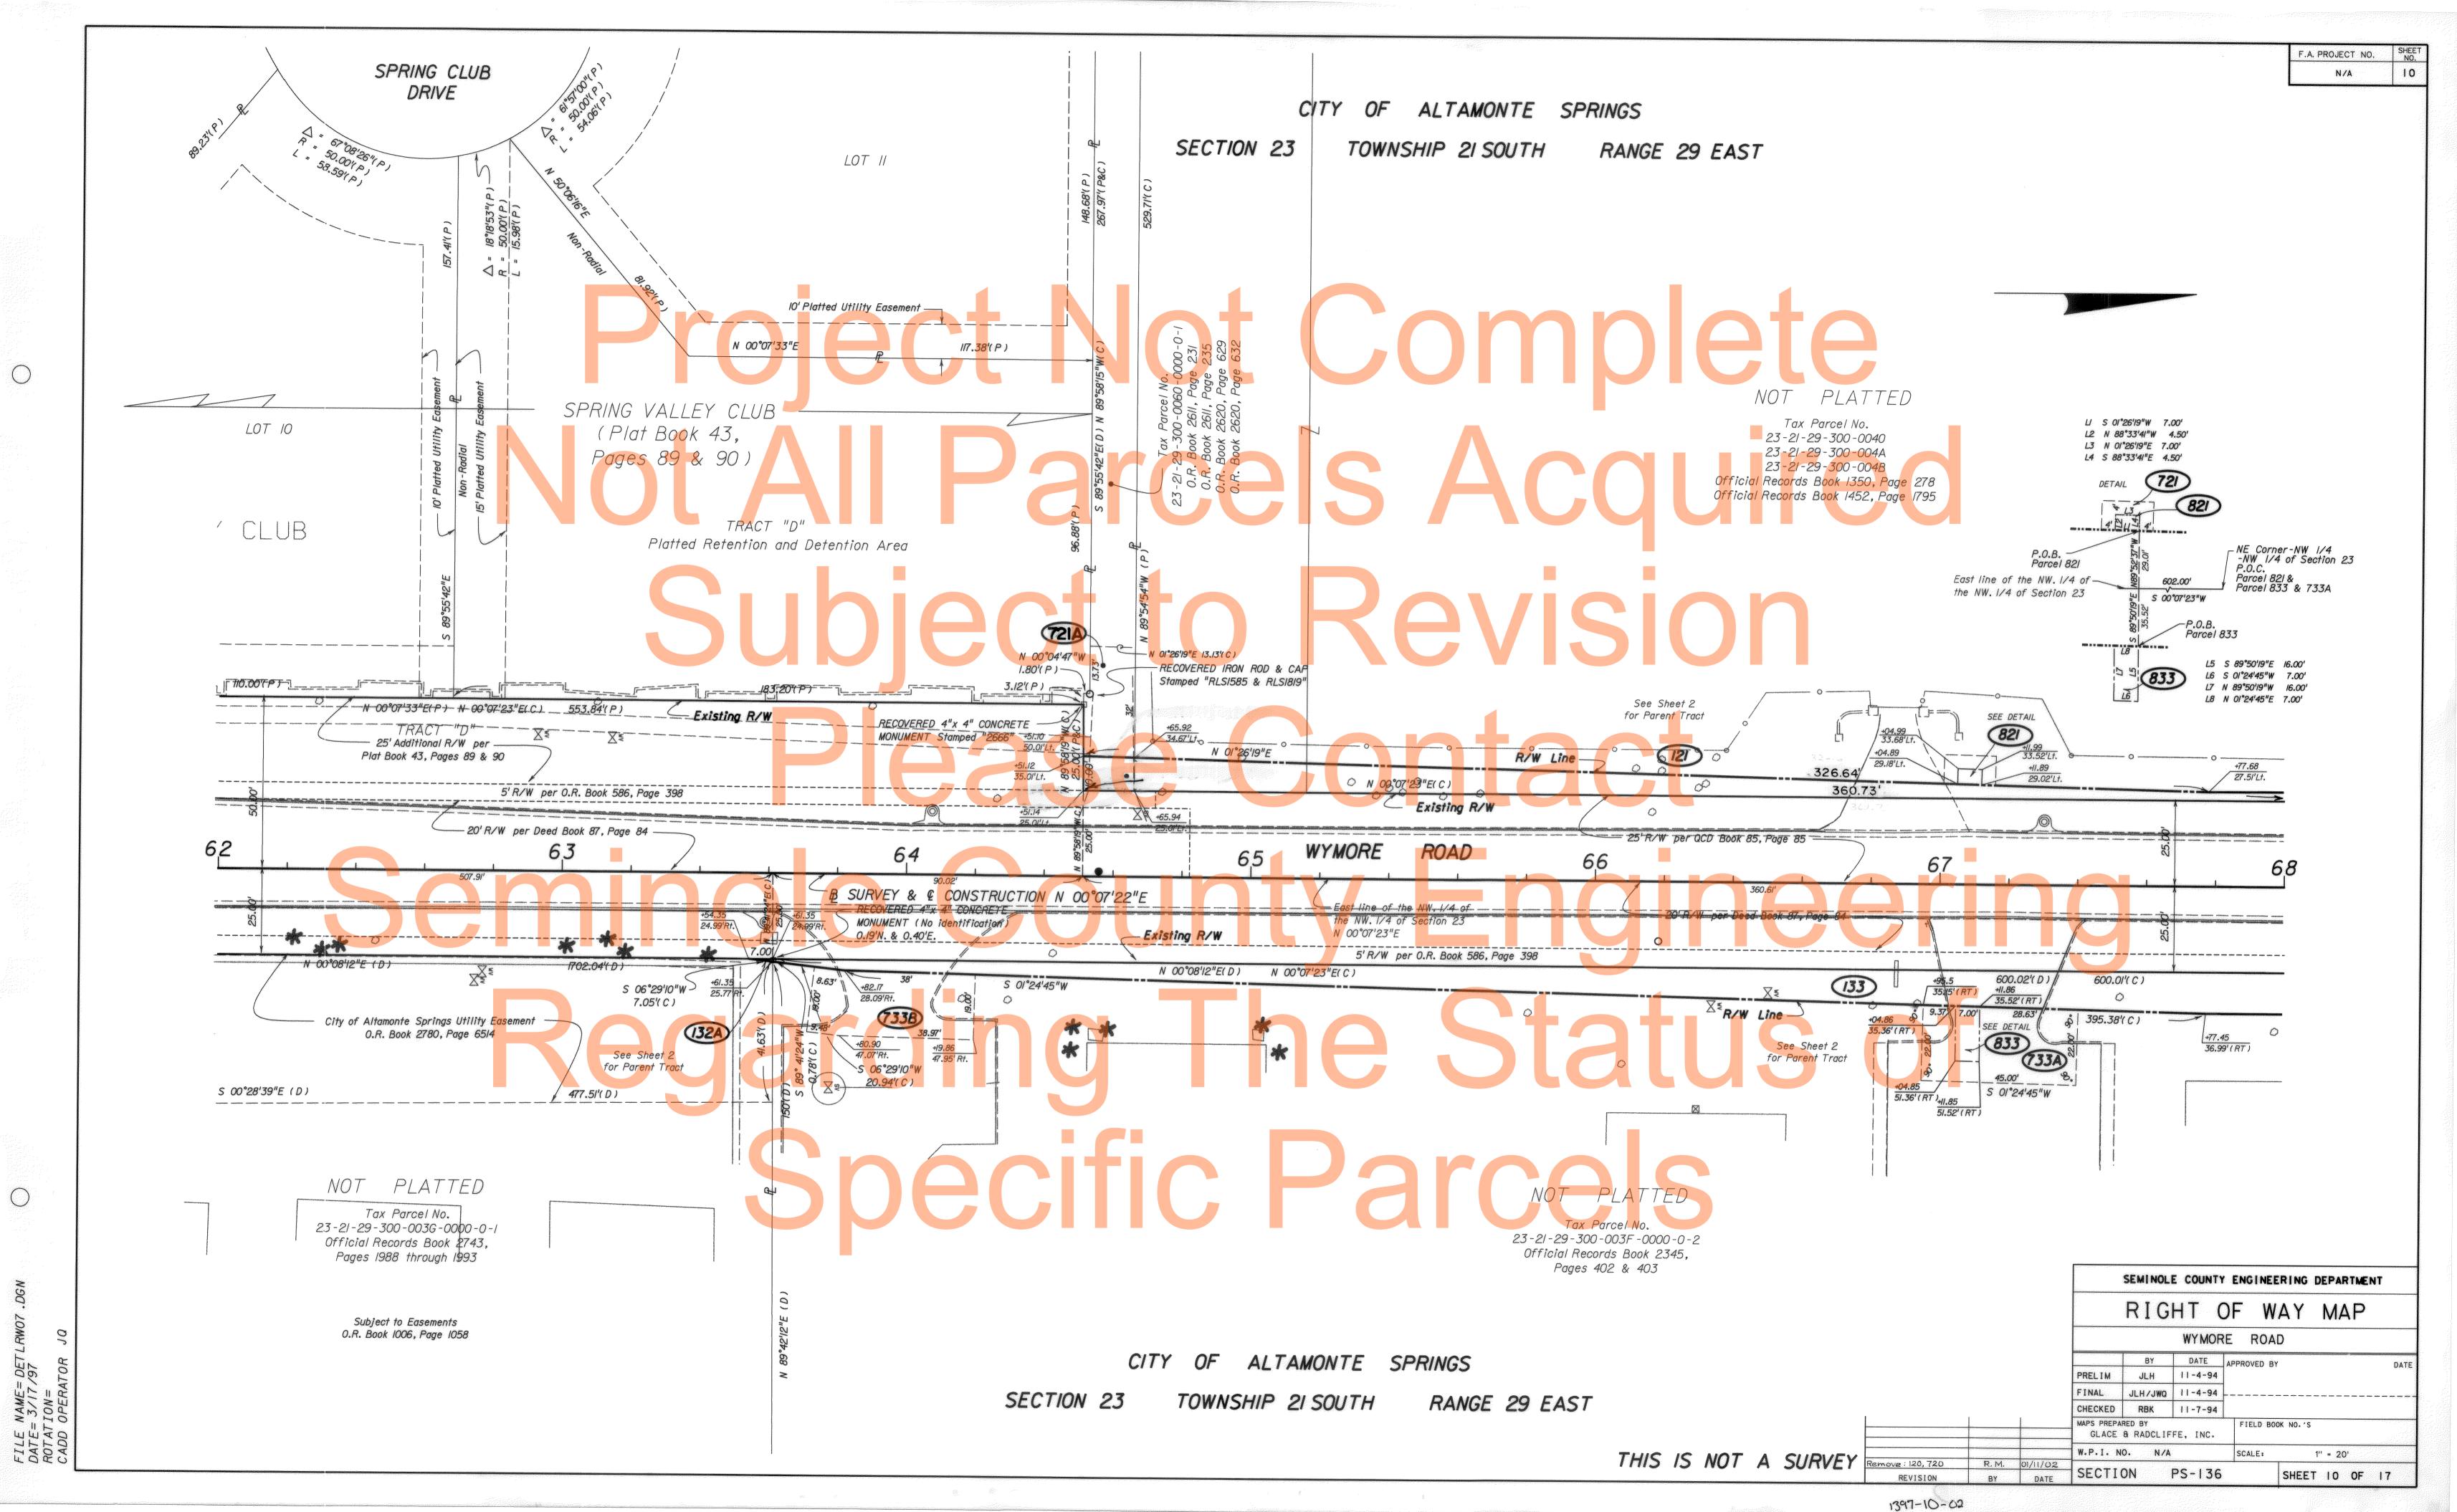

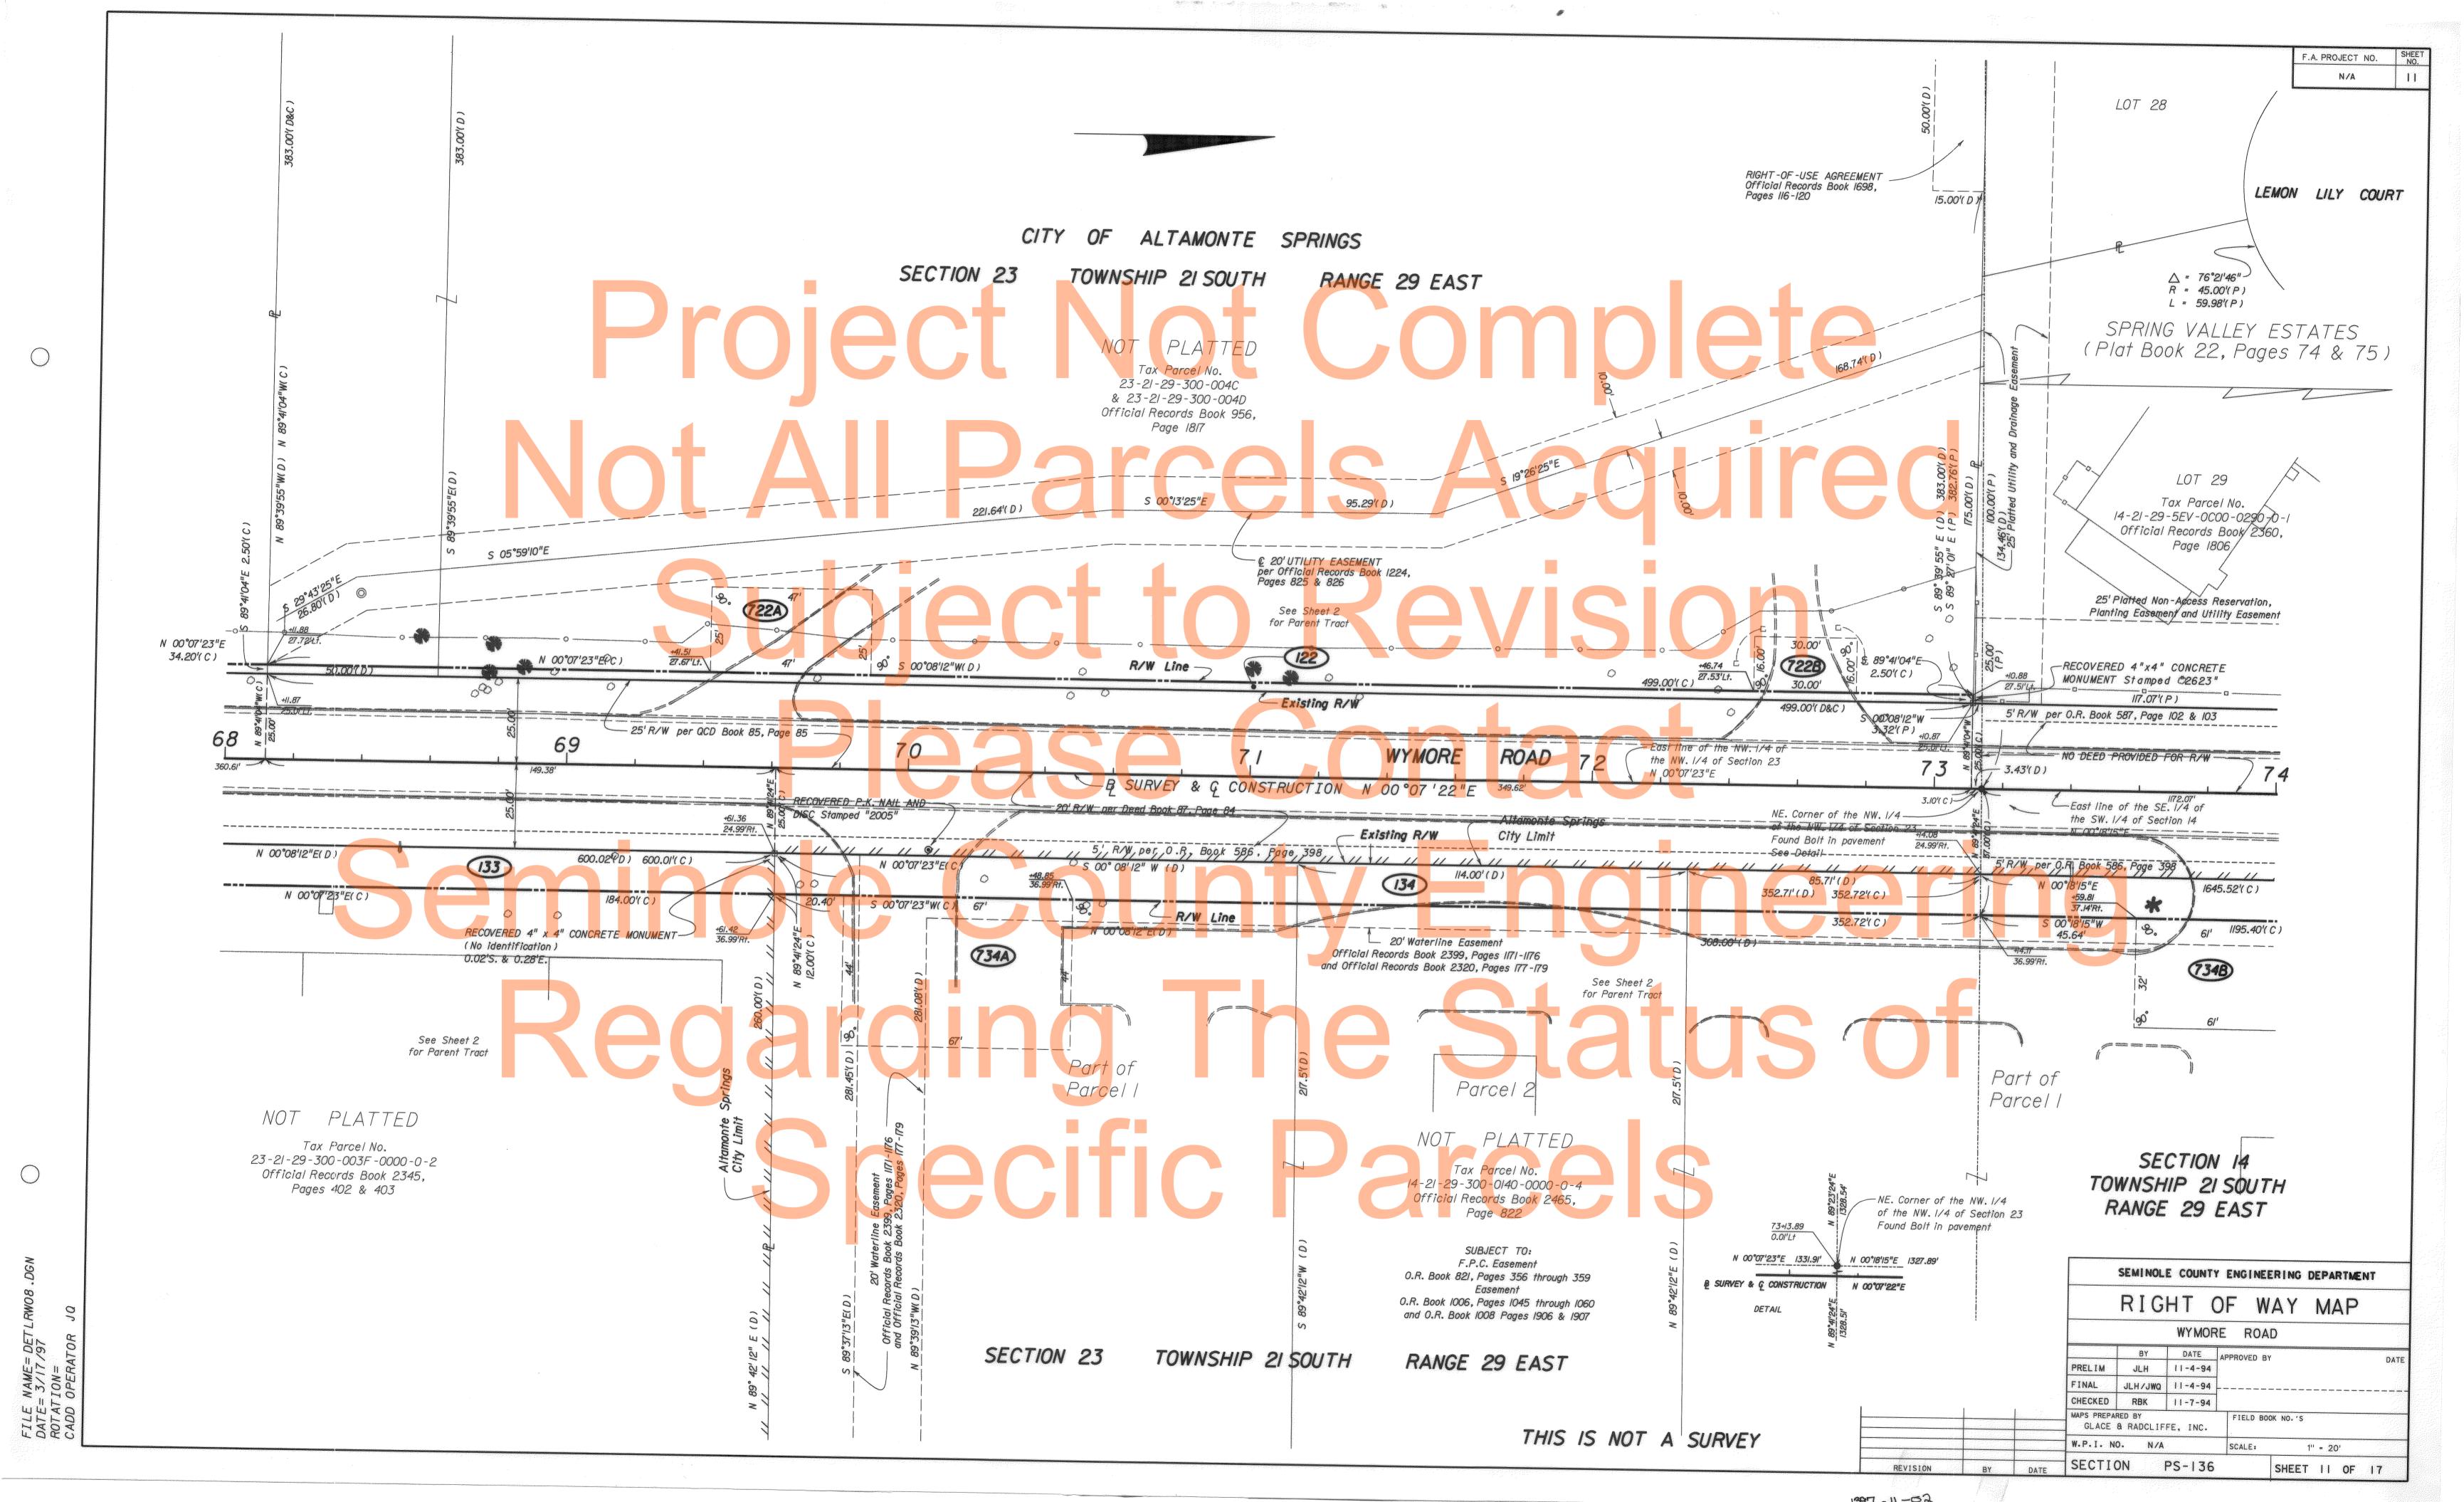


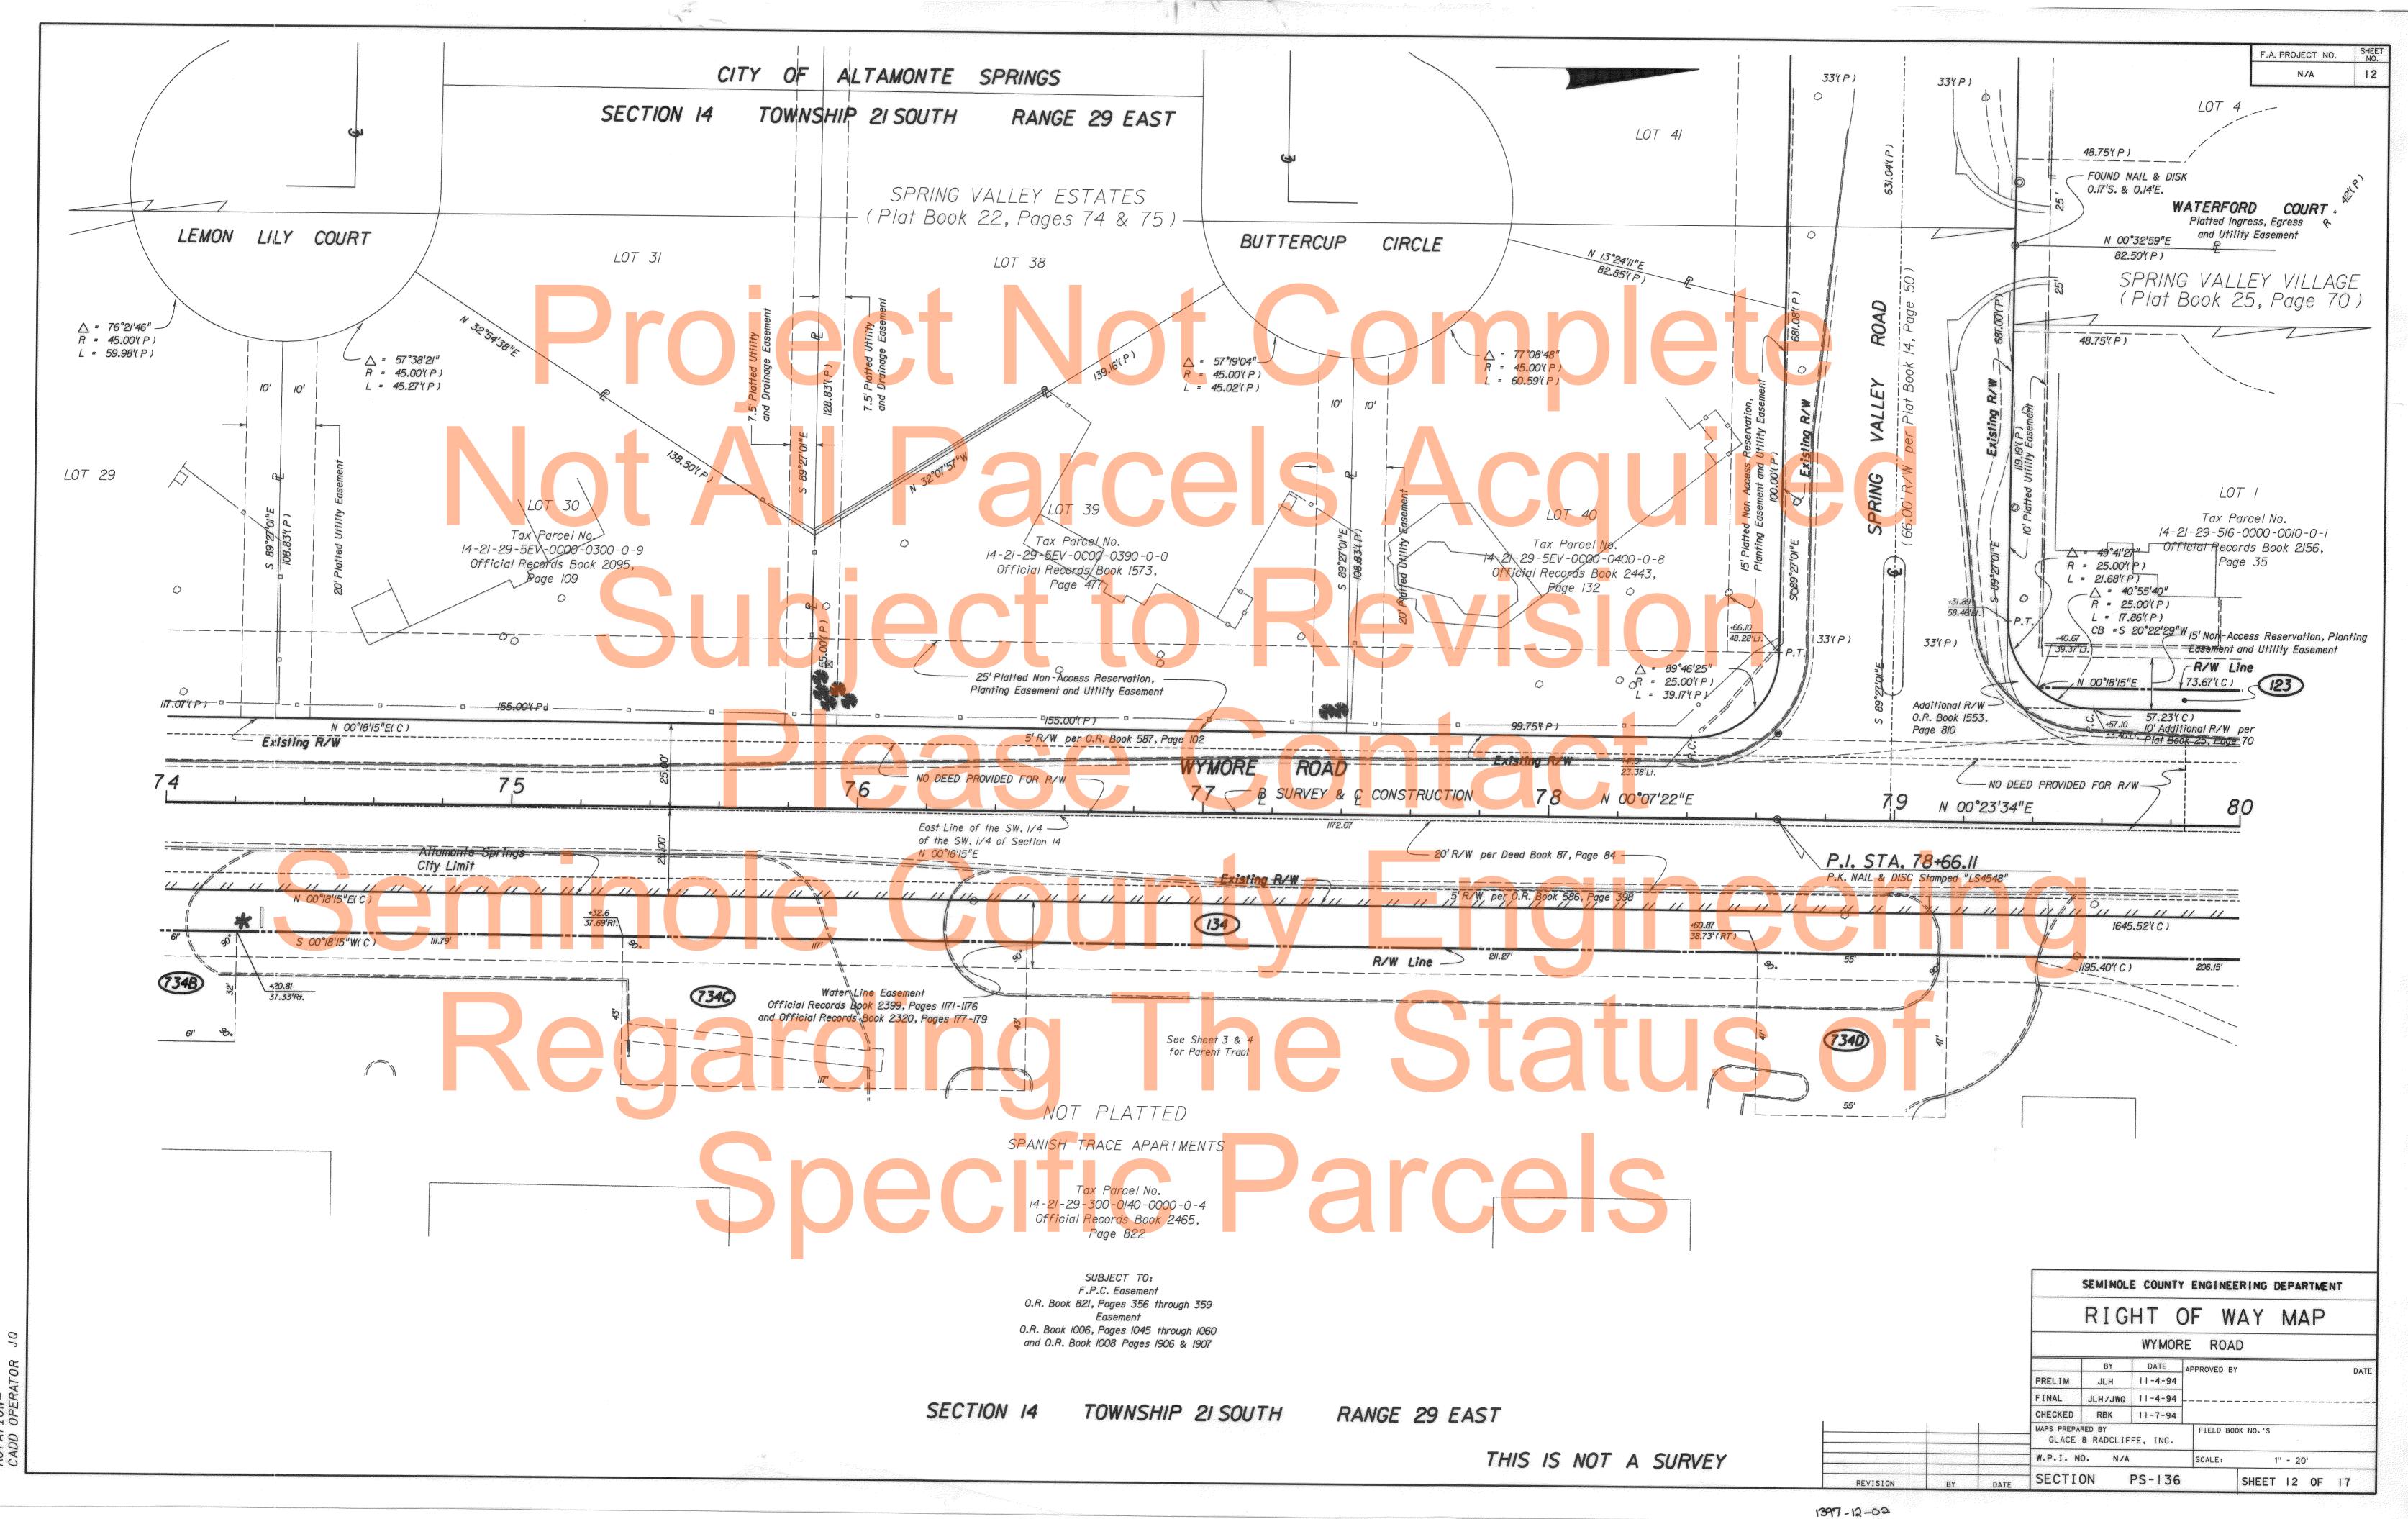

 $\bigcirc$ 


DG.


AME = DET 3/17/97

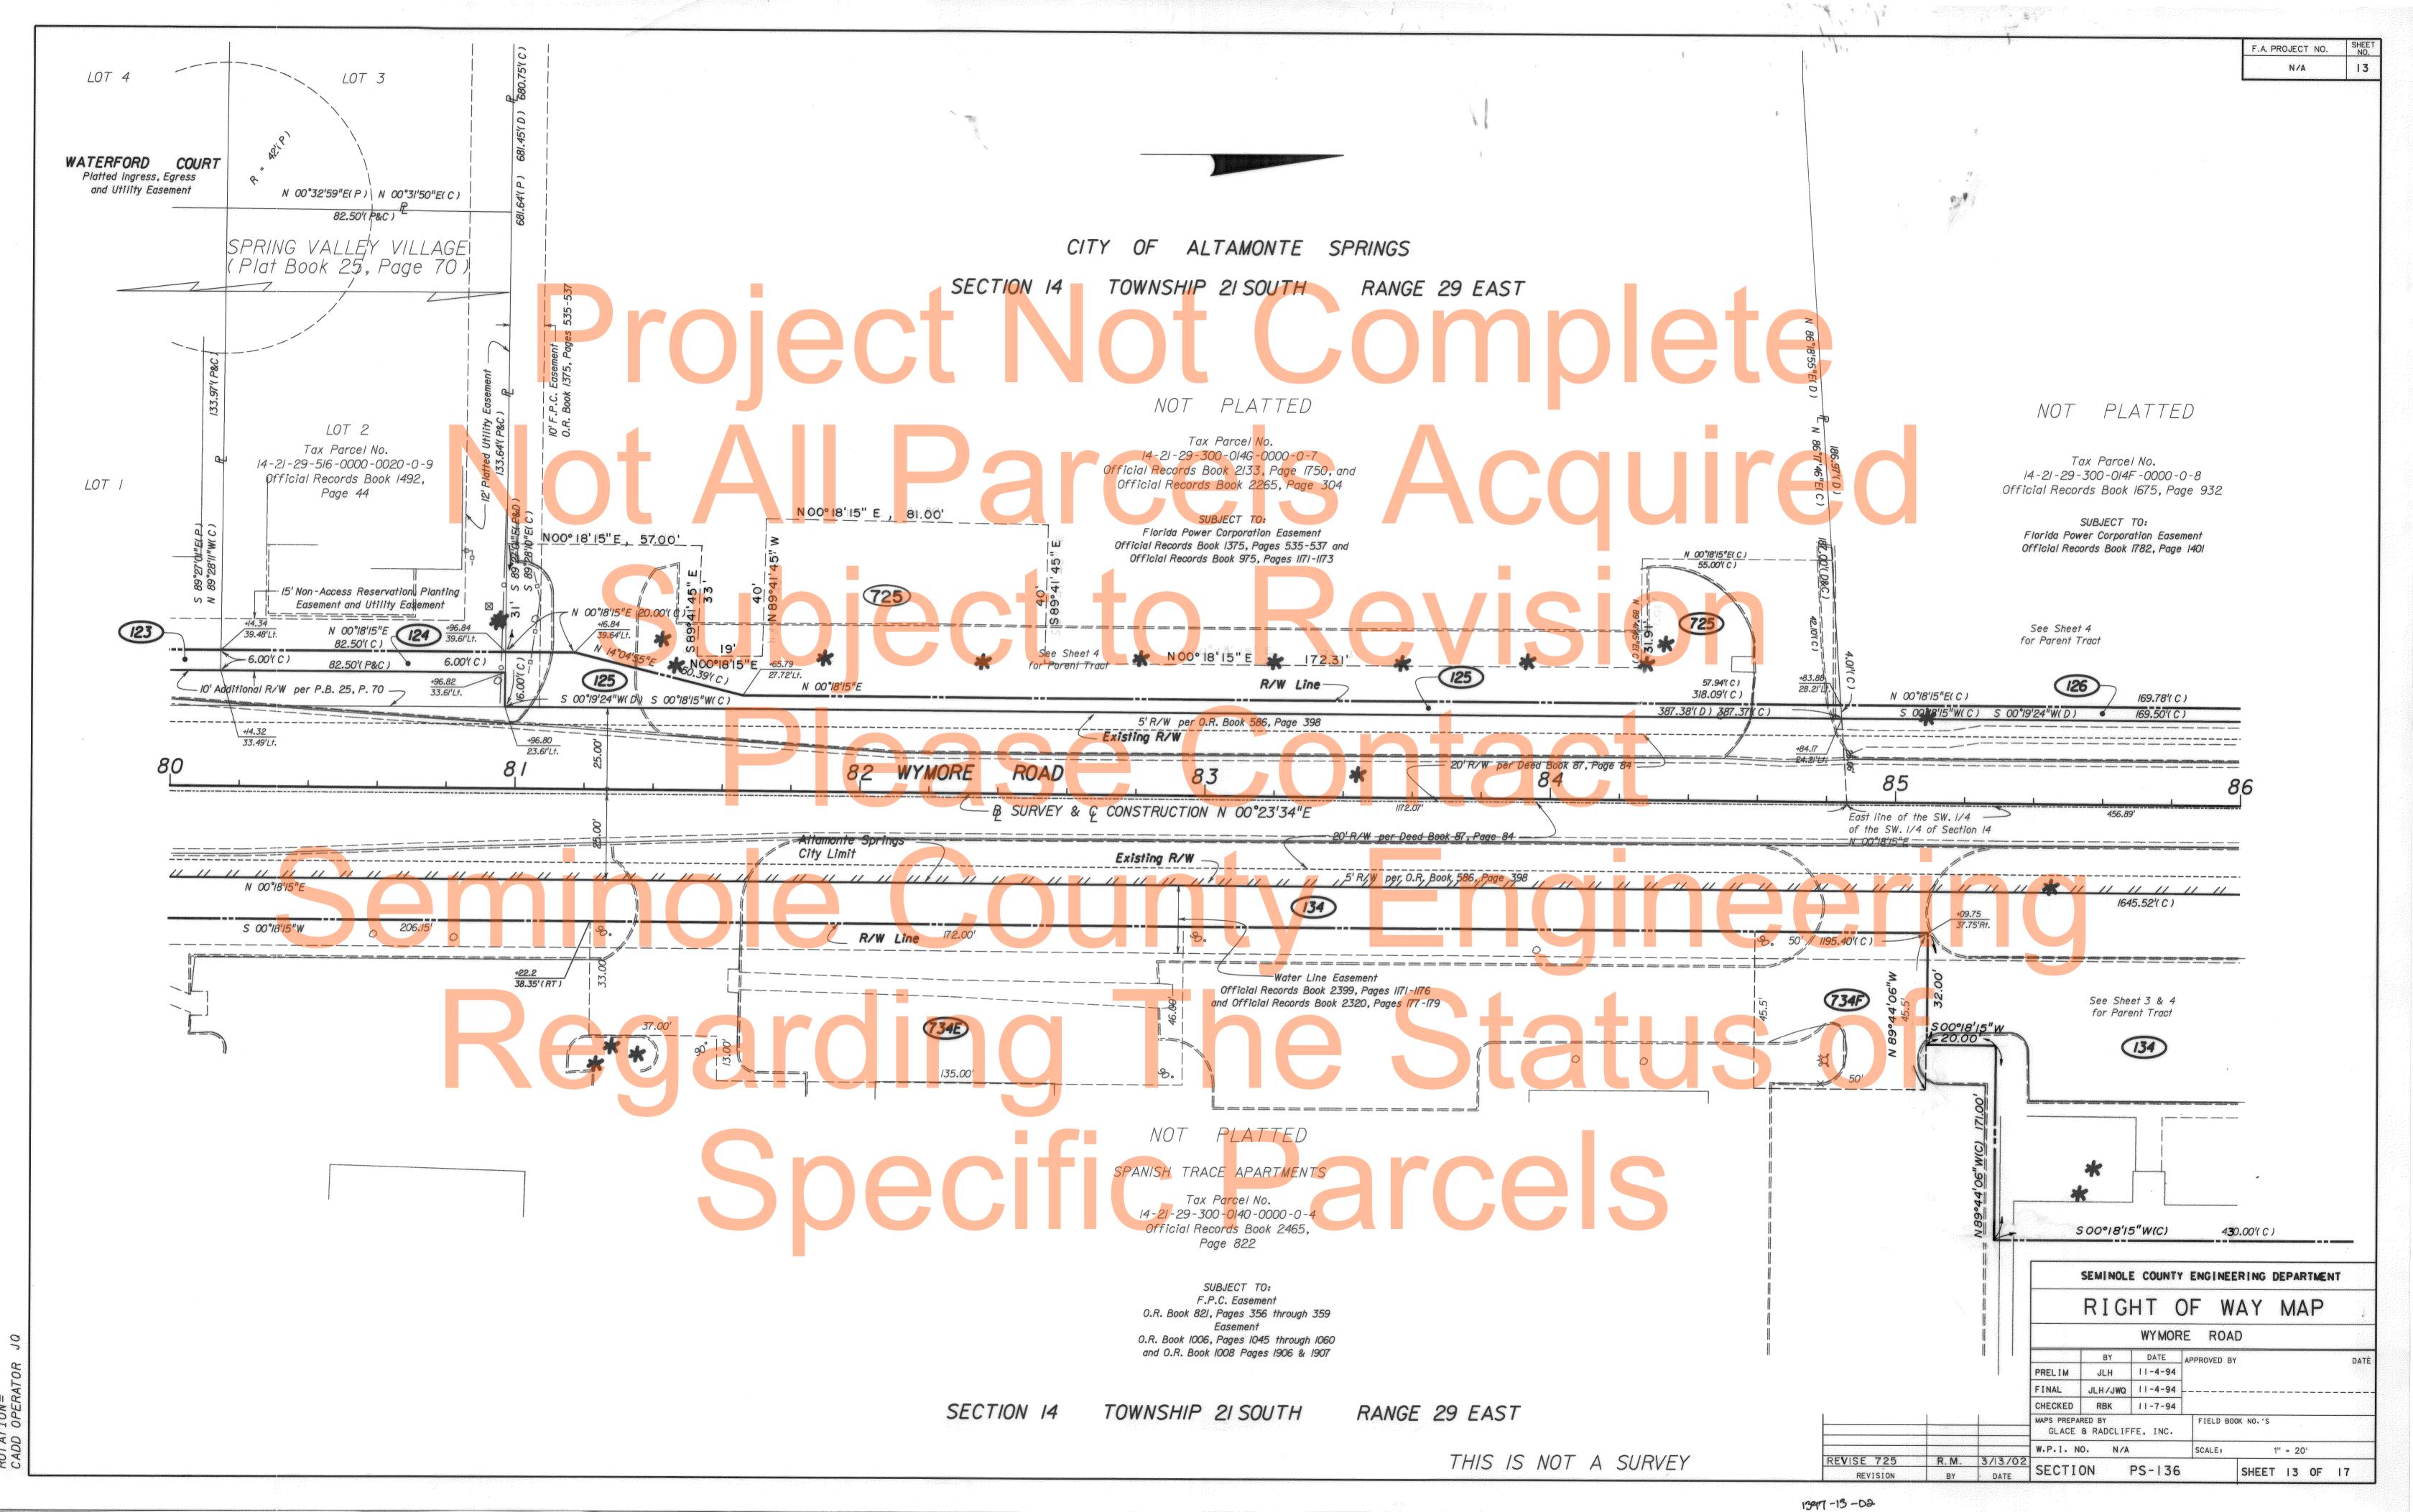

 $\bigcirc$ 

FILE NAME= DETLRWIO DATE= 3/17/97 ROTATION=

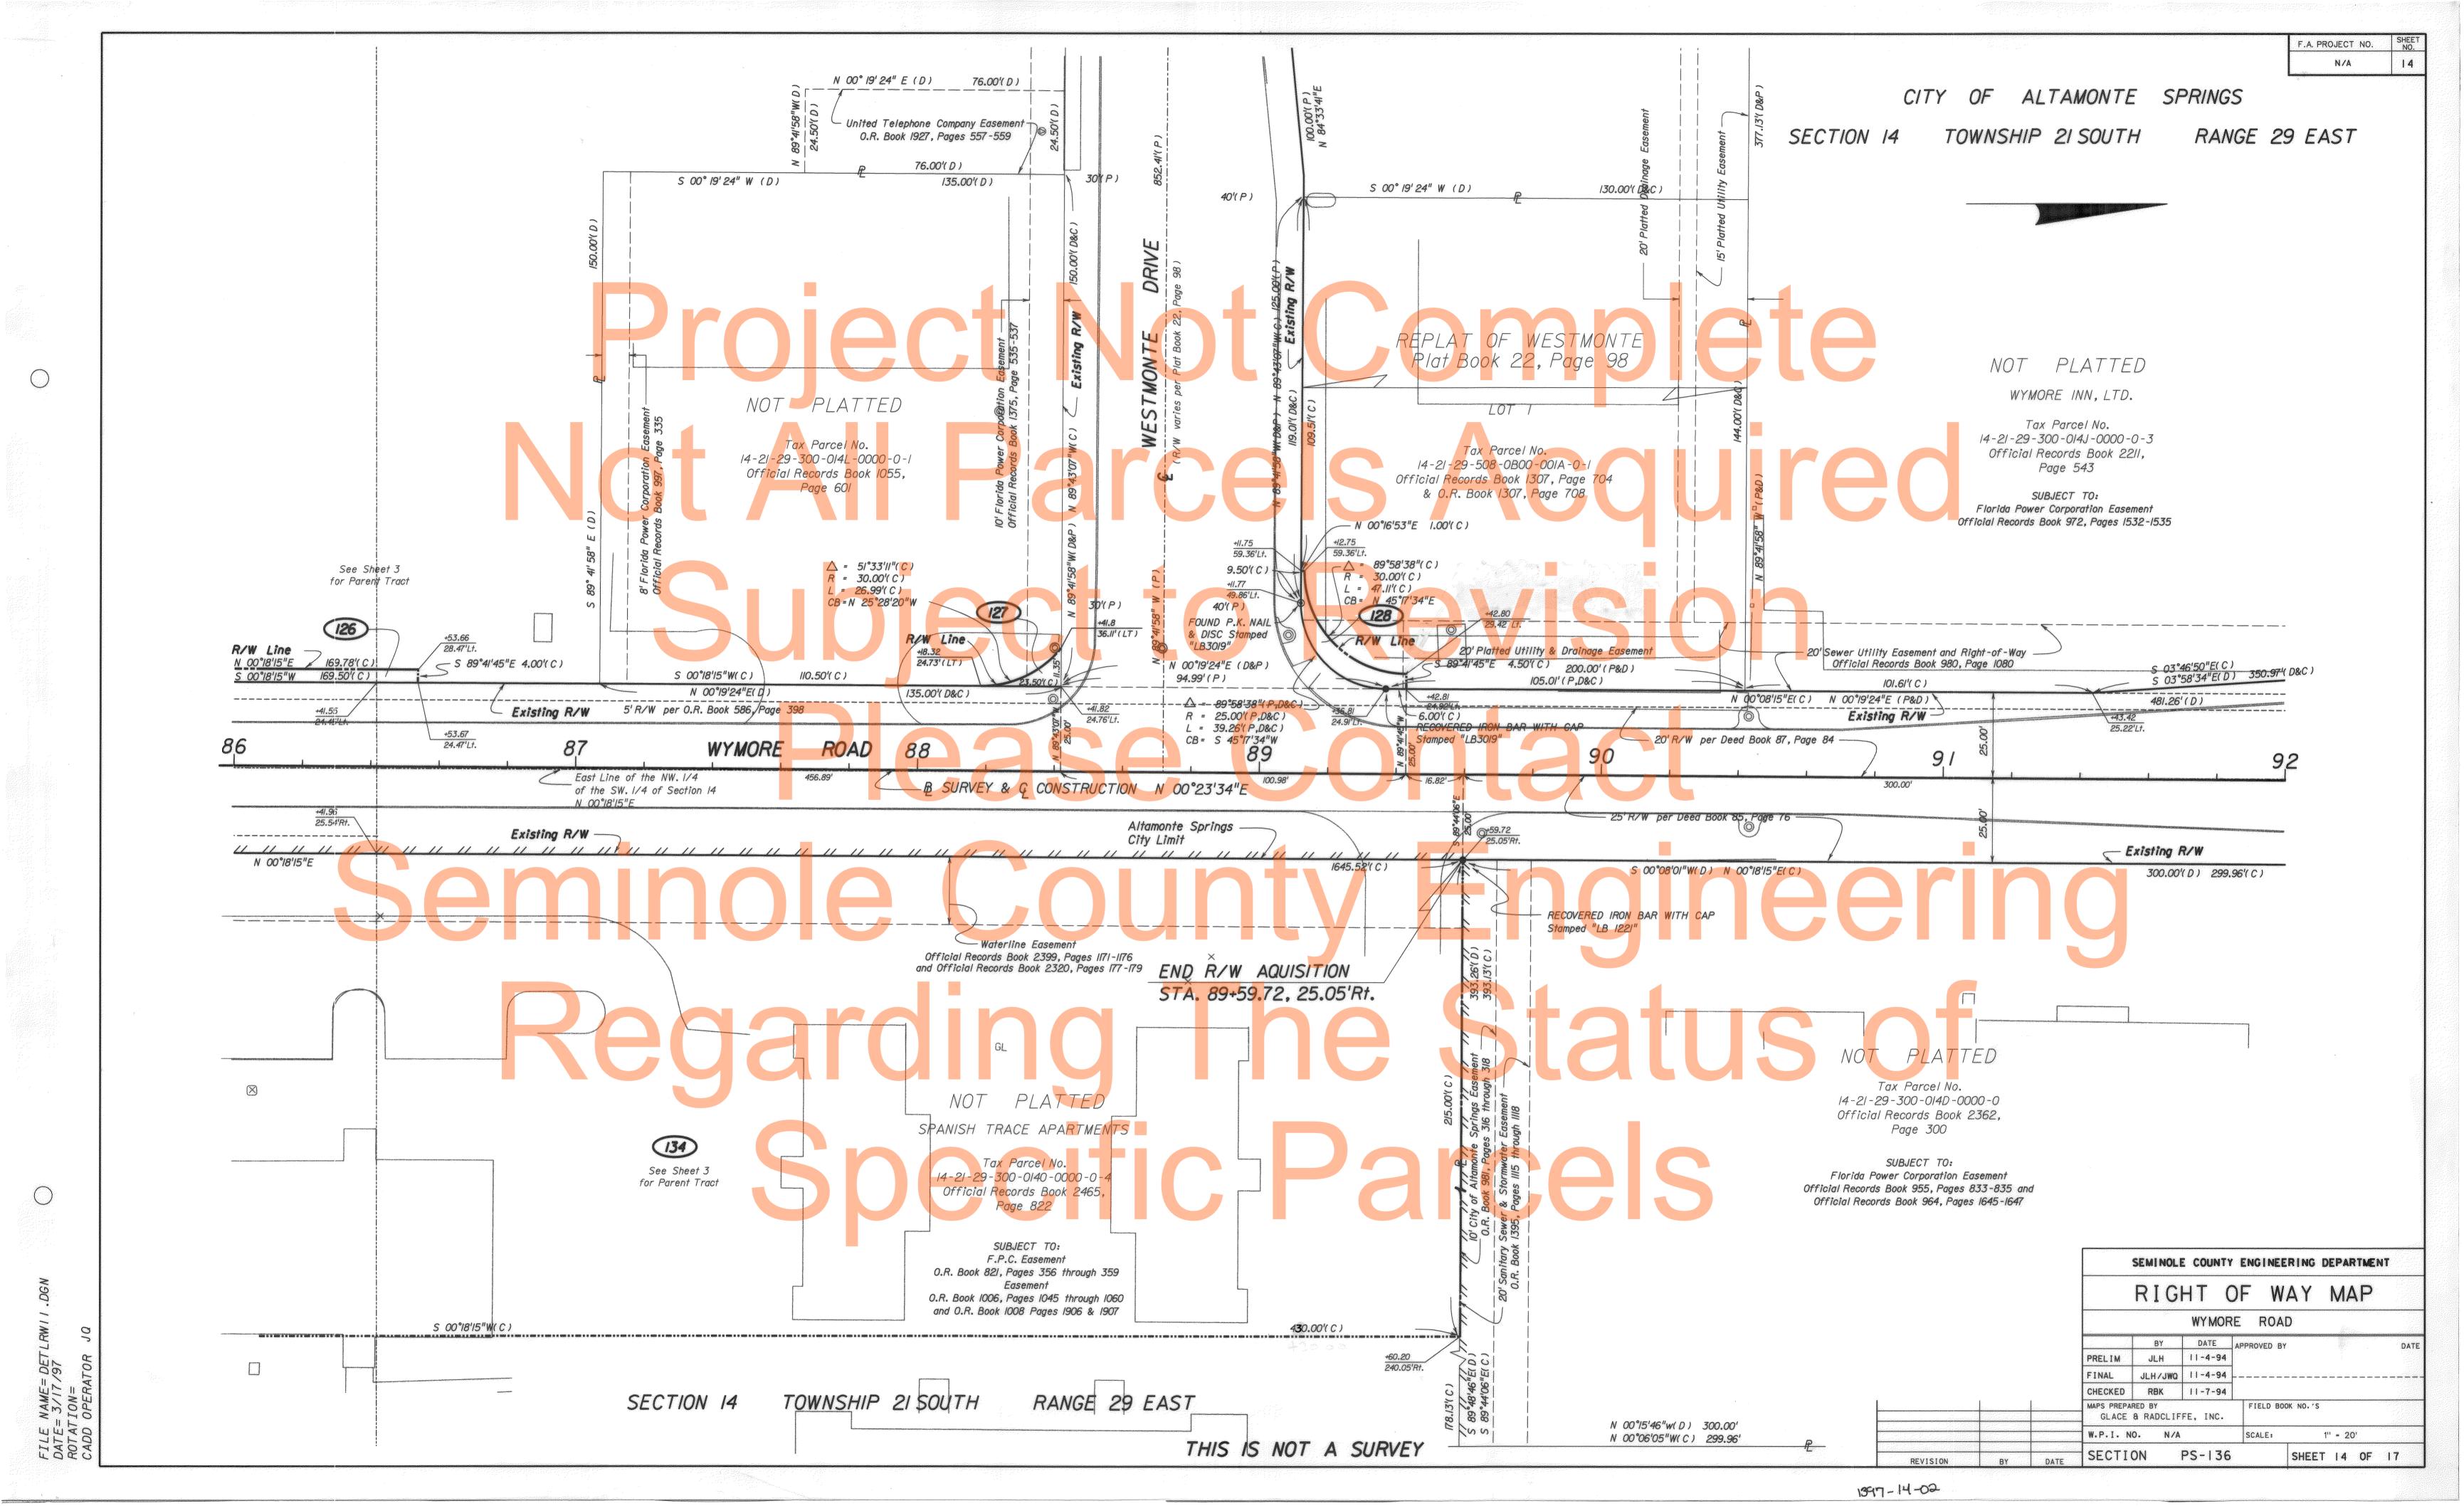

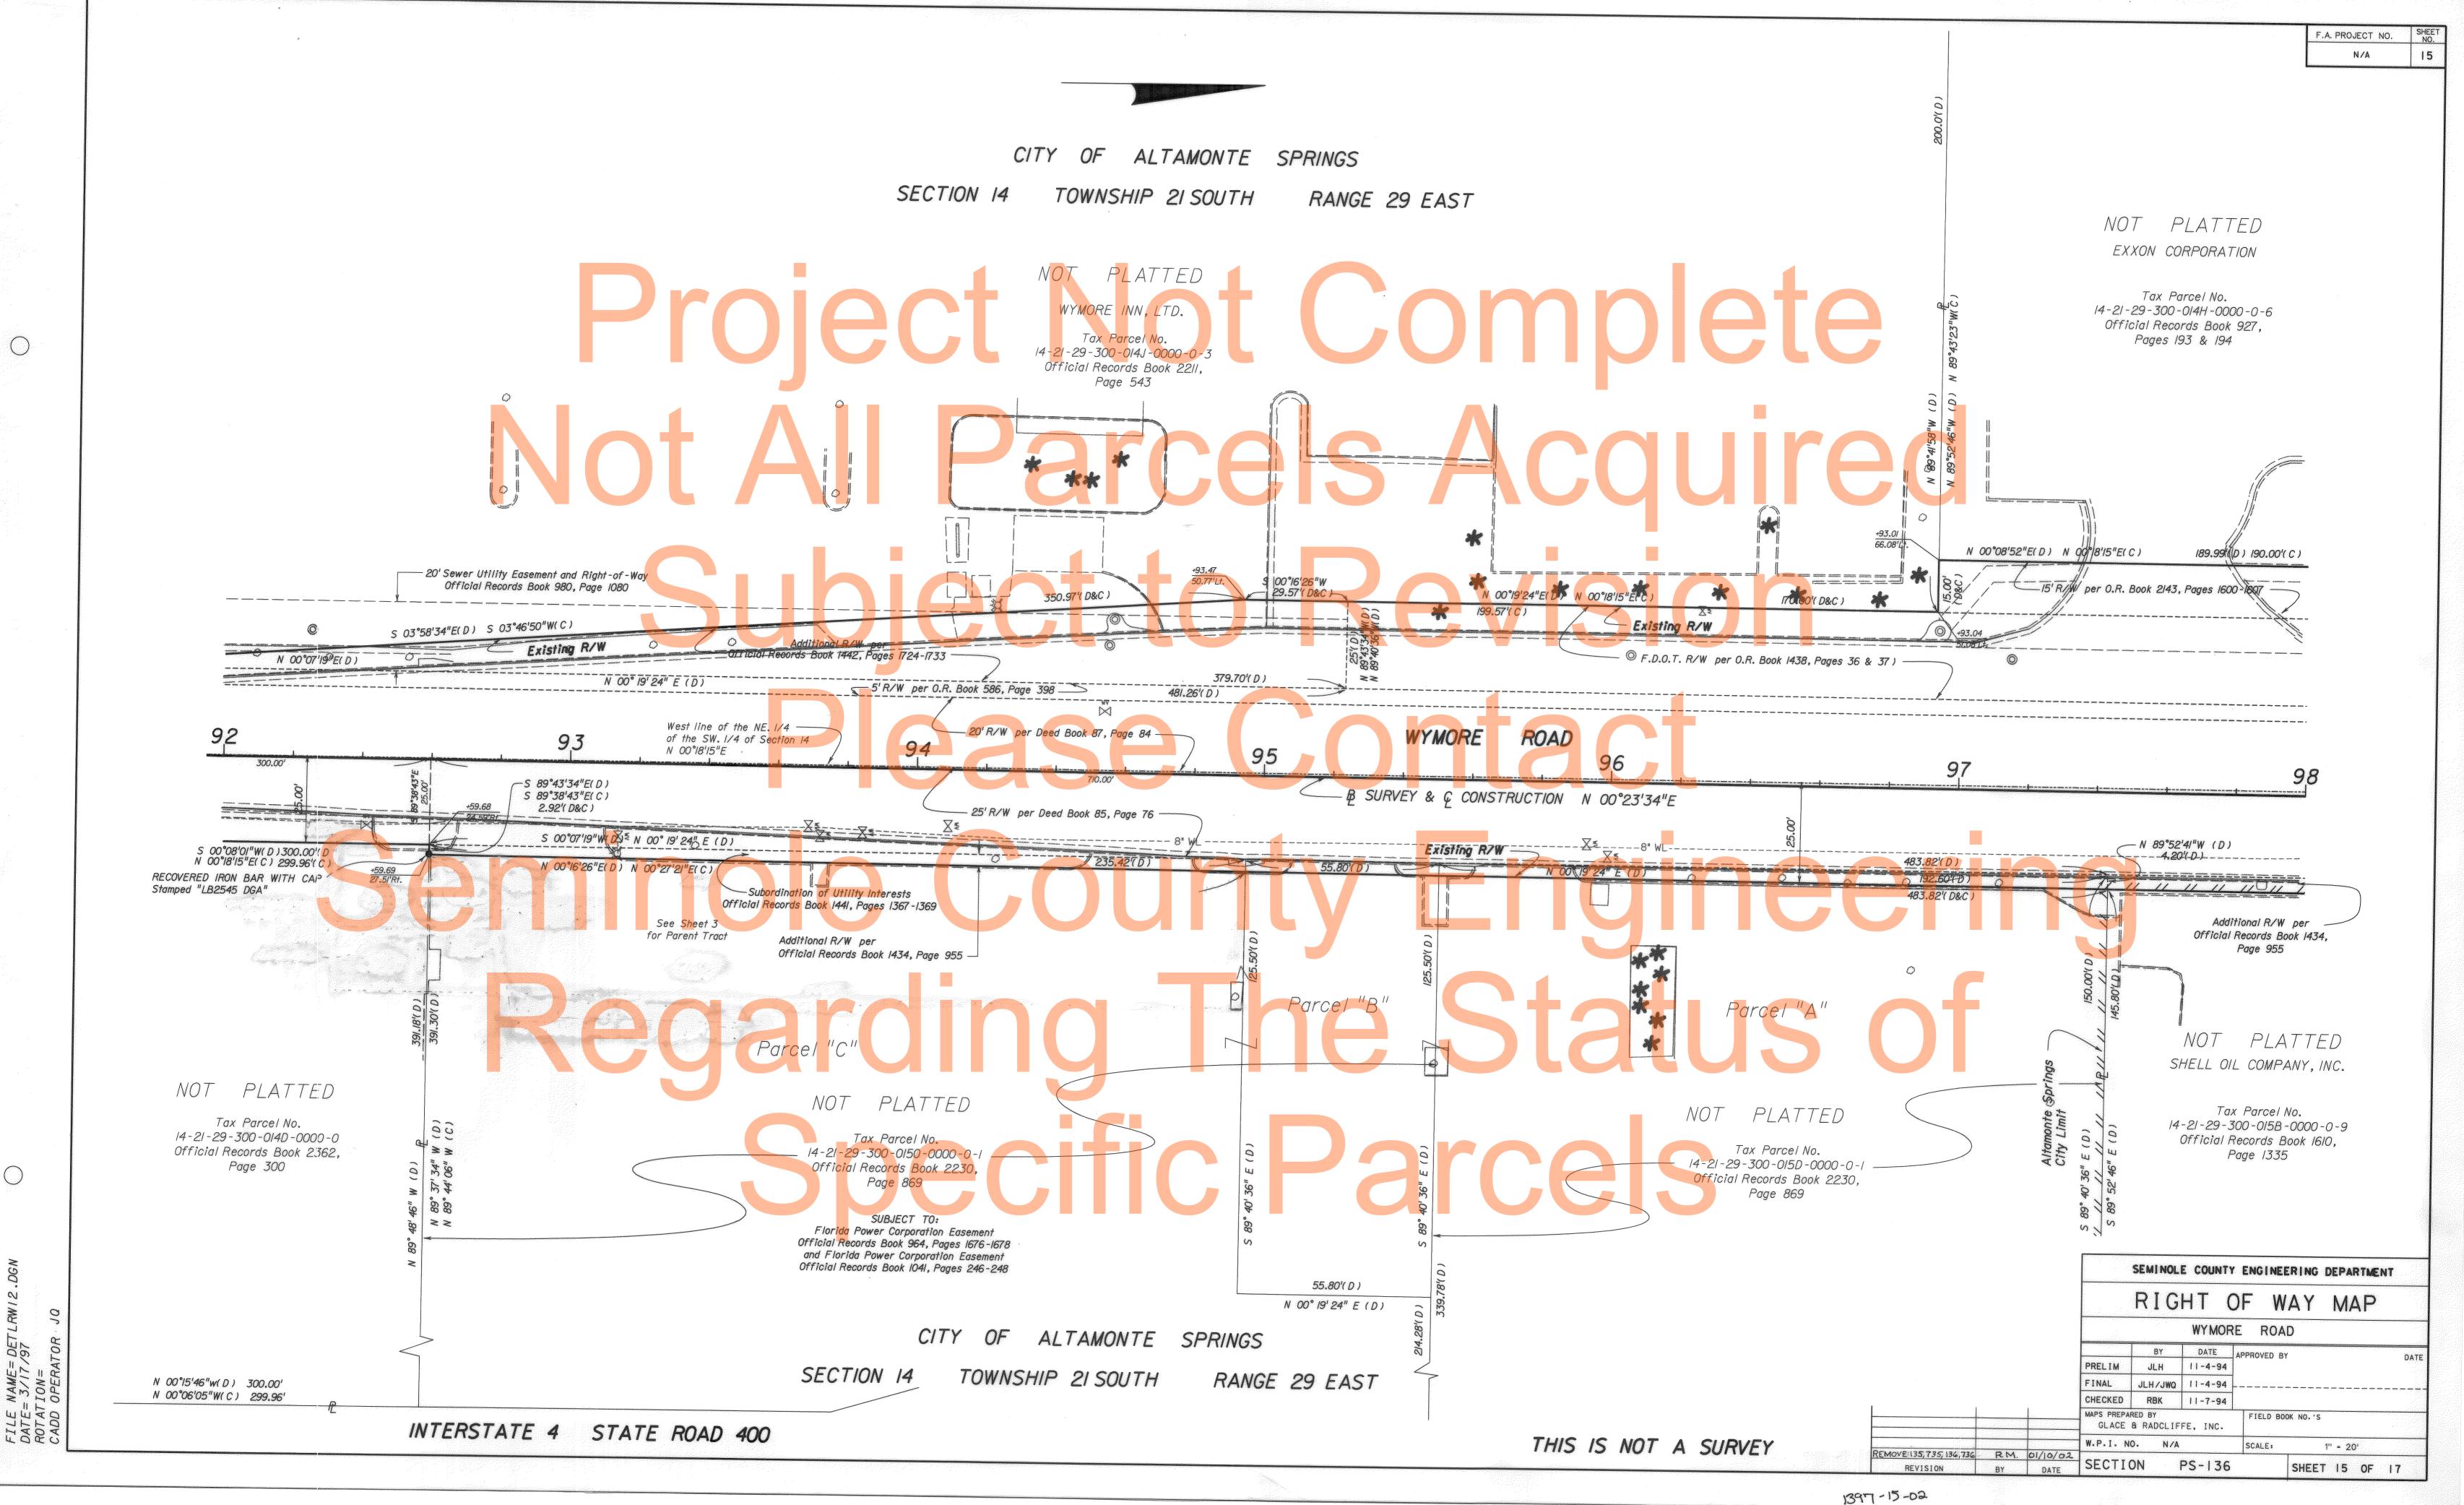


 $\bigcirc$ 

DG

N.

AW.

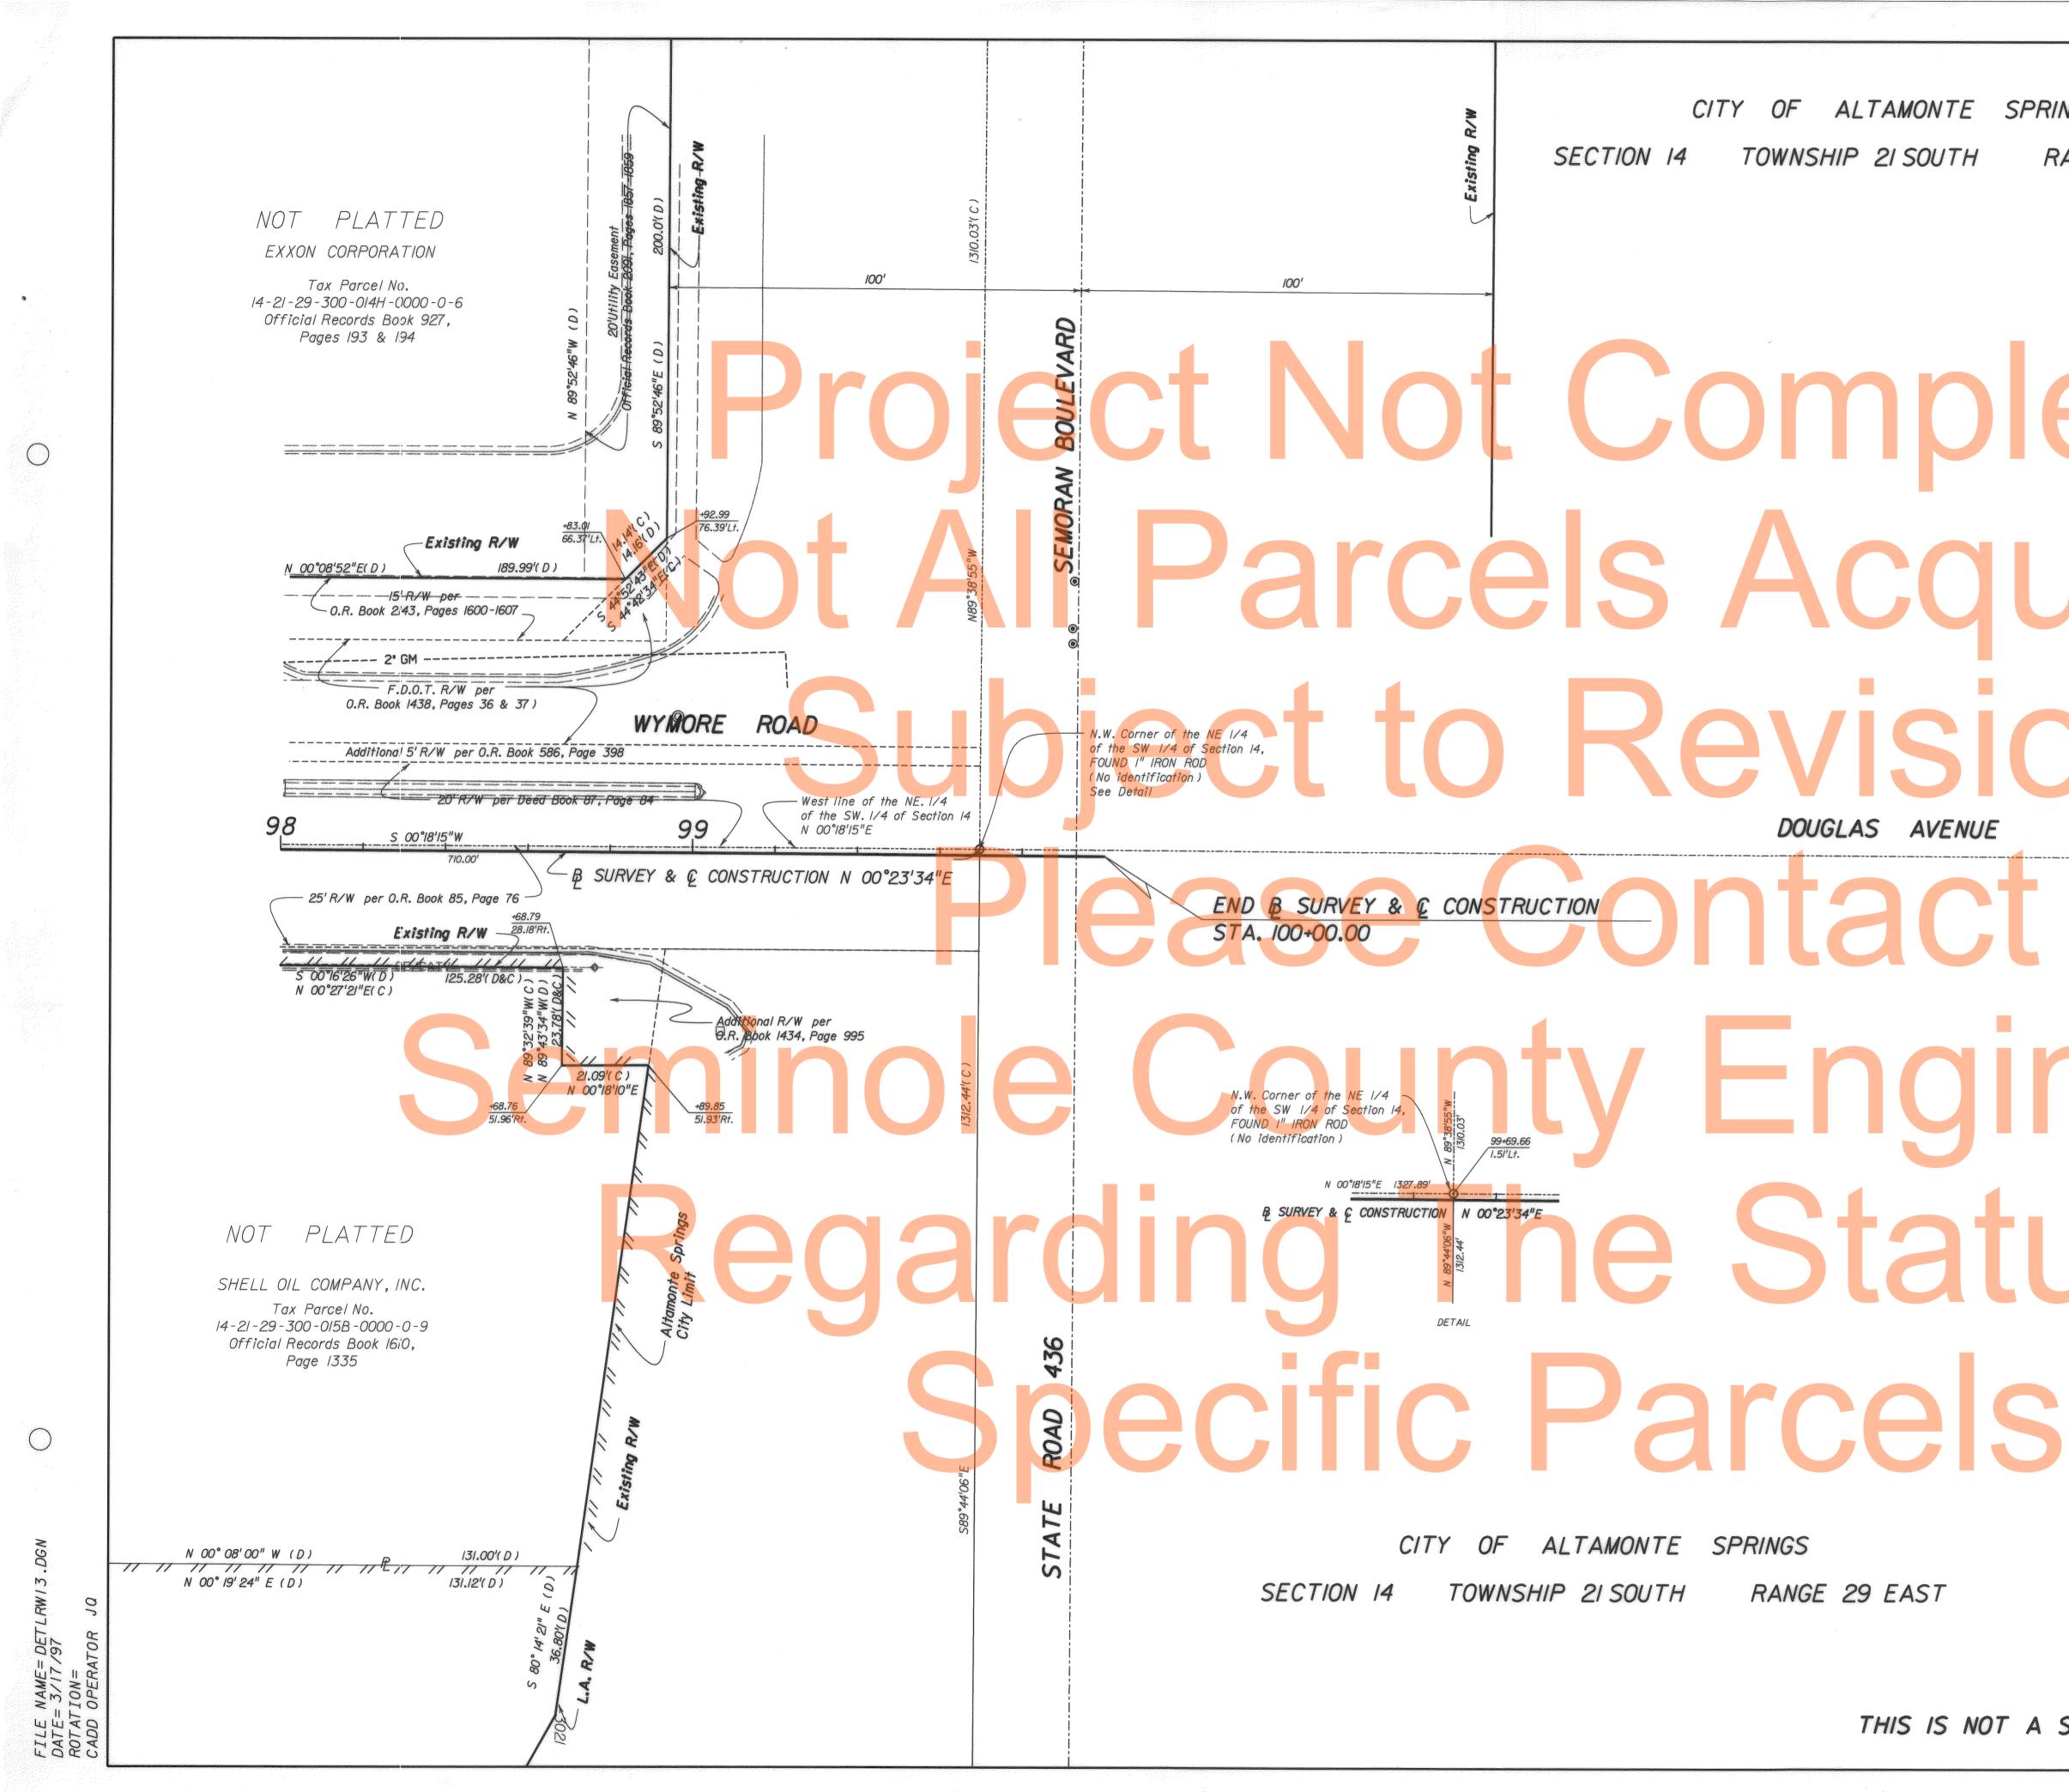

				F.A. PROJECT NO.	SHEET NO.
INGS				L	
11105					
RANGE 29 EAST					
$\frown$					
$\mathbf{A}$					
	1				
		alana ili alan alan alan alan alan alan	a construction data and an and and an and and and an and and	a un contes no teo medate un un subien un un contes un un objece de dé détairé un un déside	
<b>N</b>					
		SEMINO	E COUNTY ENGINE		<del></del>
					•
		RIG	HT OF W	VAY MAP	
			WYMORE ROA	4D	
		BY BY	DATE APPROVED E	ЗҮ	DATE
		PRELIM JLH FINAL JLH/JWQ	11-4-94	aa aana aana ahah aha ana ana ana ana aha ah	
		CHECKED RBK	11-7-94		
		MAPS PREPARED BY GLACE & RADCLIF		00K NO.'S	
SURVEY		W.P.I. NO. N/A	ini and the second s	1 <sup>11</sup> = 20 <sup>1</sup>	
l l	REVISION BY DAT	SECTION	PS-136	SHEET 16 OF	17
1897-	-16-02				
1 <b>6</b> 3 1		Announce and the second se			

																		F.A. PROJECT NO.
ARCEL SHEET IMBER NUMBER	OWNER	INSTRUMENT	TOTAL AREA PARCEL	AREA TAKE	REMAINDER	R IGHT	COMMENTS	RECORDING DATA	PARCEL NUMBER	L SHEET R NUMBER	OWNER	INSTRUMENT	TOTAL AREA PARCEL	AREA TAKE	REM, LEFT	NINDER RIGHT	COMMENTS	RECORDING DATA
	EQUITY REALITY, INC.		20.943AC. 21,280 S.F.		20.943AC.				801		EQUITY REALITY, INC.			12,1738.F	12,173			
	WINFIELD S. ADAMS, a married person and				5,510 S.F.				821 829A,B		TIMOTHY S. BRUMLIK AND PATRICIA BRUMLIK, his wife BUENA VISTA PARTNERS, LTD., a Florida limited partnership			32 S.F. 7,0,07 S.F.	7007			
	IEANNE M. ADAMS, his spouse							- -	830A,B		JOON SUK YANG AND WON T. YANG			322 S.F.				
	DOUGLAS BRUCE BROWN and SUE WILLIAMS BROWN , his ROBIN LILLIBRIDGE and MARY JEAN LILLIBRIDGE, his wife				6,406 S.F.				83/A,B		BUENA VISTA PARTNERS, LTD., a Florida limited partnership			446 S.F.				
	CLIFTON C. FANCHER and FRANCES J. FANCHER, his wife		15,648 S.F.		,537 S.F.				832A,B	9 - 10	JACKSON/PACESETTER LIMITED PARTNERSHIP, a Florida			745 S.F.				
108 6 M	MARY J. SHEARER, Trustee		14,310 S.F.	190 S.F. 14	,120 S.F				833	10	JACQUES-MILLER INCOME FUND II, Special Asset partnership			112 S.F.				
	CARMEN C. SANTIAGO, surviving spouse of		13,452 S.F.	190 S.F. 13	1,262 S.F.						(LaPlaza), L.P.							
	Martin A. Santiago, deceased G. VERNON STYRON, JR. and GRACE L. STYRON, his wife		12,880 S.F.	184 S.F. 12	2,696 S.F.													
	ARNOLD A. ABRAMSON' AND DIANE W. ABRAMSON, his wif			the second s	,696 S.F.													-
	ROBERT TURNER BOWLES and JERRI ELSNER BOWLES, hi	wife			2,874 S.F.													
	STEVEN T. SEED AND AUDREY SEED, his wife RONALD R. RAIKE AND ANITA M. RAIKE, his wife		13,525 S.F.	202 S.F. 13 205 S.F. 14	and the second secon				-701		EQUITY REALITY, INC.							
	CAROL G. CRISCI, a married woman, f/k/a Carol G. Gravett,			210 S.F. 15							JOHN F. HORVATH, as Trustee of John F. Horvath Revocable			<del>10,332 S.F.</del> 452 S.F.				
	ioined by her husband, PETER G. CRISCI										Trust dated June 3, 1993 as to undivided 1/2 interest, ANTONIA							
	IARIO RIVERON AND HELIODORA M. RIVERON, his wife				,946 S.F.						W. HORVATH, as Trustee of Antonia W. Horvath Revocable Trus							
	IOHN P. MCGUIRE, JR. AND SUZANNE H. MCGUIRE, his wife			1 S.F. 17 358 S.F. 18	,748 S.F.				72	10 & 11	dated June 3, 1993, as to an undivided 1/2 interest TIMOTHY S. BRUMLIK AND PATRICIA BRUMLIK, his wife			96 S.F.				
	IND RUTH C. MCGUIRE								722A,B	11	WILLIAM R. BEURET, Trustee			1,655 S.F.				
	OHN T. HENRY, JR. AND JANE L. HENRY, his wife			248 S.F. 19					725		DENNIS I. REESER AND DENNIS I. REESER, TRUSTEE		[2]6[3	12,613 <i>5.F</i> .				
	OHN F. HORVATH, as Trustee of John F. Herveth Reveesb rust dated June 3, 1993 as to undivided 1/2 interest, AN		-2.160 AC.	-145 S.F. 2	167-AC-				729 ,8 730 <mark>A,</mark> 8	+	BUENA VISTA PARTNERS, LTD., a Florida limited partnership JOON SUK YANG AND WON T. YANG			436 S.F.	436			
	HORVATH, as Trustee of Antonia W. Horvath Revocable								73/A,B	<u>_</u>	BUENA VISTA PARTNERS, LTD., a Florida limited partnership			413 S.F.				
	ated June 3, 1993, as to an undivided 1/2 interest								732	7 - 10	JACKSON/PACESETTER LIMITED PARTNERSHIP, a Florida			5,160 S.F.				
	FIMOTHY S. BRUMLIK AND PATRICIA BRUMLIK, his wife		4.387 AC.	1,98/ S.F. //.					A,B,C,D		limited partnership							
	ELIA M. MENDEZ				,519 S.F.				733A,B	10 & 11	JACQUES-MILLER INCOME FUND II, Special Asset partnership (LaPlaza), L.P.	*		1,782 S.F.				
124 13 W	VILSON SELPH AND LOUIS E. SELPH			495 S.F. 10	,544 S.F.				734 A,B,C,	11 - 14	RESOLUTION TRUST CORPORATION, as Conservator for Franklin			20,520 S.F.				
	DENNIS I. REESER AND DENNIS I. REESER, TRUSTEE			2,083 S.F <mark>.</mark> 10					D,E,F		Federal Savings Association							
	SPRINGS COLONY VENTURE, a joint venture		10.451 AC.		.435 AC.				735-		IUPITER HOTELS LIMITED PARTNERSHIP, a IIIinoio limited partnership			<del>-527 S.F.</del>				
	EORGE A. STEPHAN AND CHRISTINE R. STEPHAN		18,586 S.F.						736		EASTPOINTE TOWERS ASSOCIATES, LTD., a Florida			-8,899-5.F.				
	SUENA VISTA PARTNERS, LTD., a Florida limited partners			3,069 S.F.		9/ AC.					limited partnership							
	OON SUK YANG AND WON T. YANG DUENA VISTA PARTNE <mark>RS, LTD., a Florida limited par</mark> tne <mark>rs</mark>	10		4,675 S.F. 2,965 S.F.		30 AC. 46 AC.												
	ACKSON/PACESETTER LIMITED PARTNERSHIP, a Florida		13.686 AC.			55 AC.			721	10	PEIRCE HOLDING LLC			96 5.F.				
	imited partnership							•	721A	10	PEIRCE HOLDING LLC			452 J.F				
	ACQUES-MILLER INCOME FUND II, Special Asset partnersh LaPlaza ), L.P.		8.23/ AC.	5,233 S.F.	8.//	// AC.	**************************************											
	ESOLUTION TRUST CORPORATION, as Conservator for Fra	klin	18.208 AC.	2.648 AC.	15,56	60 AC.												
	ederal Savings Association																	
<u> </u>	UPITER HOTELS LIMITED PARTNERSHIP, a IIIinois		-2.700 AC.	618 S.F.	2,68	RIAC.						5						
in the second	ASTPOINTE TOWERS ASSOCIATES, LTD., a Florida		-4.156 AC.	100 S.F.	4.15	5-AC												
-#	initod partnorship-				-													
21 10 F	ERCE HOLDINGS LLC											2 						
21 10 7	EARCE FIDEDING DEC		14.07 AC 2	11a7 5.F. 14	.va AC													
1									l									
									700-	799 TEMPOR	OF WAY TAKE RARY CONSTRUCTION EASEMENT						SEMINOLE COUNTY ENGI	NEERING DEPARTMEN
				a - 1					800-	-899 PERMAI	NENT DRAINAGE EASEMENT			*			TABLE OF O	WNERSHIP
				Y R R	8									t.			WYMORE	
										- R	an a						BY DATE APPRO	
																PI	RELIM JLH 11-4-94	מבט 10
											۰ ۲				<b>n et et en en e</b> n en	F	NAL         JLH         II-4-94            IECKED         RBK         II-7-94	
													· Printers	lelete 729 A Revise 829 A Revise 801	R.M.	12/19/02 M		ELD BOOK NO.'S
													F	Revise 725 evise 801; Change	R.M.	3/13/02 -		ALE: N/A
													R	emove: 120,13	5,736 R.M.	01/11/02	ECTION PS-136	SHEET IT C

Ó.

O FILE NAME= TABOF DATE= 3/17/97 ROTATION= CADD OPERATOR J

 $\bigcirc$